

MAY 22 2000

SECTION

LAND CORNER RECORDATION CERTIFICATE
Filing Requirement of Act 74, Mich. P.A. 1970
KENT COUNTY REMONUMENTATION

For corners in

Kent (County)	Located in: Courtland Township	Corner Code #
1. Public Land Survey	T <u>9N</u> R <u>10W</u>	<u>I-10</u>
	T _____ R _____	_____
	T _____ R _____	_____
	T _____ R _____	_____
2. Property Controlling in Section	S _____ T _____ R _____	_____
	S _____ T _____ R _____	_____
3. Miscellaneous Property in Sec.	S _____ T _____ R _____	_____
	S _____ T _____ R _____	_____
4. Lot No. _____, Recorded Plat _____		
5. Private Claims _____		

1999 OCT 15 AM 8:06

STATE OF MICHIGAN
COUNTY OF KENT
RECEIVED FOR RECORD


REG. OF DEEDS

11345

Register of Deeds Stamp & File Number

I, Randy Kolehouse, in a field survey on January 11 1999, do hereby certify that under requirements of P.A. 74 Michigan P.A. of 1970, the corner points mentioned in lines 1 and 2 above were in conformance with regulations and rules therefore as required in the current manual of survey instructions of the United States Department of the interior, Bureau of Land Management or by a decree of a Court of Law and/or that the corner points mentioned in lines 3, 4 and 5 above were in conformance with the rules of the Michigan Board of Land Surveyors or by a Decree of a Court of Law; established, re-established, monumented, re-monumented, recovered, found as expressed below:

NOTE: Not more than 4 corners, all in the same town and range, may be recorded on this certificate.

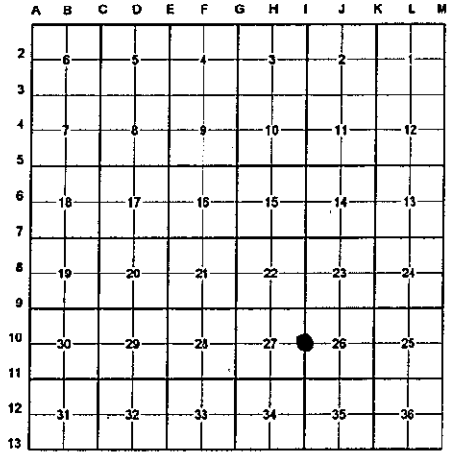

A. Description of original monument and accessories and/or subsequent restoration:

I-10	1837	G.L.O. Notes	Cathcart	Set Post
	1972	L.C.R.C. #356	Williams & Works	Iron
	1982	L.C.R.C. #3283	C. Hay	Fnd. 3/4" Iron / Set K.C. Monument
	1992	L.C.R.C. #6247	C. Marschall	K.C. Monument

P.A. 345 1990 KENT COUNTY
PEER APPROVED 2/25/99
CHAIRMAN [Signature]

This corner was originally approved by the Kent County Remonumentation Peer Group and monumented by C. Hay on 2/11/82 and was recorded per L.C.R.C. #3283.

B. Description of corner evidence found and/or method applied in restoring or reestablishing corner:

I-10 Found a Standard Kent County Monument 2.0' West of the C/L of Young Avenue (bit.) running North and South, on line of a fence line running East and West, per L.C.R.C.'s #3283 and #6247 as set by C. Hay in place of a 3/4" iron he found which checked L.C.R.C. #356.

L.C.R.C. #3283

L.C.R.C. #6247


- Nail and remon. Tag in top of wood fence post, N 90° E 29.95'
- Nail and remon. tag in East side of 30" Maple, N 13° W 159.28'
- Nail and remon. tag in East side of 28" Maple, N 11° W 200.89'
- Nail and remon. tag in North side of Cons. Power Pole, N 88° W, 72.76'

- "X" Chiseled S end 12" Conc. drive culvert S 37° W 30.42' (m. 30.56')
- Nail & Tag E sd. 36" Maple N 09° W 200.74' (m. 200.72')
- Nail & Tag E sd. 36" Maple N 10° W 159.13' (m. 159.13')
- Nail & Tag N sd. U.P. N 90° W 72.71' (m. 72.76')
- Nail & Tag top of 8" Dia. Gate post N 90° E 31.37' (m. 31.38')

The selected location is accepted by me and is generally accepted by professional surveyors as the best available evidence of the position of the original corner.

C. Description of monument for corner and accessories established to perpetuate locating the position of the corner:

- I-10 Standard Kent County Monument
- "X" S end 12" conc. drive culvert S 37° W 30.56'
 - Nail & K.C. remon. tag on E side 36" Maple N 09° W 200.72'
 - Nail & K.C. remon. tag on E side 36" Maple N 10° W 159.13'
 - Nail & K.C. remon. tag on N side U. pole N 90° W 72.76'
 - Nail & K.C. remon. tag on top 8" gate post N 90° E 31.38'
 - C/L of bit. road running N-S, East 2.0'
 - On fence line running E-W

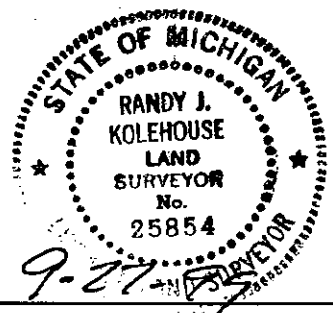

Signed by [Signature]
WILLIAMS & WORKS

Date 9-27-99

Surveyor's Michigan License No. 25854