

MAY 28 2000

SECTION

LAND CORNER RECORDATION CERTIFICATE
Filing Requirement of Act 74, Mich. P.A. 1970
KENT COUNTY REMONUMENTATION

For corners in

Kent (County)	Located in: Courtland Township	Corner Code #
1. Public Land Survey	T <u>9N</u> R <u>10W</u>	<u>J-5</u>
	T _____ R _____	_____
	T _____ R _____	_____
	T _____ R _____	_____
2. Property Controlling in Section	S _____ T _____ R _____	_____
	S _____ T _____ R _____	_____
3. Miscellaneous Property in Sec.	S _____ T _____ R _____	_____
	S _____ T _____ R _____	_____

REG. OF DEEDS

[Signature]


STATE OF MICHIGAN
COUNTY OF KENT
RECEIVED FOR RECORD
1999 OCT 15 AM 8:06

11351

Register of Deeds Stamp & File Number

4. Lot No. _____, Recorded Plat _____
5. Private Claims _____

I, Randy Kolehouse, in a field survey on February 1 19 99, do hereby certify that under requirements of P.A. 74 Michigan P.A. of 1970, the corner points mentioned in lines 1 and 2 above were in conformance with regulations and rules therefore as required in the current manual of survey instructions of the United States Department of the interior, Bureau of Land Management or by a decree of a Court of Law and/or that the corner points mentioned in lines 3, 4 and 5 above were in conformance with the rules of the Michigan Board of Land Surveyors or by a Decree of a Court of Law; established, re-established, monumented, re-monumented, recovered, found as expressed below:

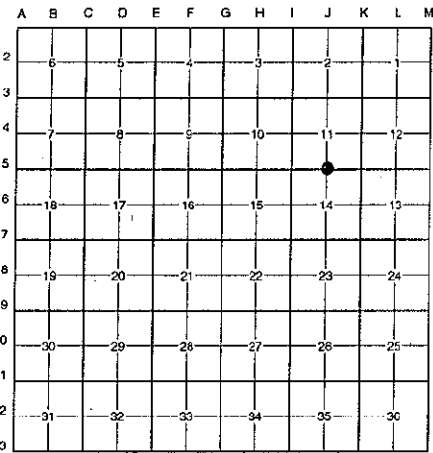

NOTE: Not more than 4 corners, all in the same town and range, may be recorded on this certificate.

A. Description of original monument and accessories and/or subsequent restoration:

J-5	1837	G.L.O. Notes	Cathcart	Set Post
	N/A	Witness Map	K.C. Surveyor	N/A
	1973	L.C.R.C. #516	Exxel Engineering	1/2" Iron
	1982	L.C.R.C. #3049	Jonker Land Survey	Fnd. 1/2" Iron / Set K.C. Monument
	1991	L.C.R.C. #6241	C. Marschall	K.C. Monument

This corner was originally approved by the Kent County Remonumentation Peer Group and monumented by Rob Jonker on 8/2/88 and was recorded per L.C.R.C. #3049.

B. Description of corner evidence found and/or method applied in restoring or reestablishing corner:

J-5 Monument had been removed. Found a PK nail 6.3' South of the C/L of 14 Mile Road (bit.) (M-57) running East and West, on line of a fence line running South. Found PK nail checks witnesses from L.C.R.C.'s #516, #3049 and #6241.

L.C.R.C. #3049

Remon. tag on SW side p.pole S60°E 162.82'
Remon. tag on W side 20" Beech S0°W 97.77'
Remon. tag on NE side 16" Poplar N40°W 139.82'
C/L E-W pvt. N 6.2'

L.C.R.C. #6241

Nail & Tag NW sd. 22" Beech S 0 E 97.76' (m. 97.83')
Nail & Tag NW sd. 22" Maple N 44 E 122.71' (m. 122.70')
Nail & Tag W sd. 12" Oak N 0 W 92.03' (m. 91.98')
Nail & Tag NE sd. 22" Oak S 63 E 152.66' (m. 152.66')
Centerline E-W Rd. N 6.0' (m. 6.5')

The selected location is accepted by me and is generally accepted by professional surveyors as the best available evidence of the position of the original corner.

C. Description of monument for corner and accessories established to perpetuate locating the position of the corner:


J-5 Reset a Standard Kent County Monument

Nail & K.C. remon. tag on NW side 22" Beech S 00° E 97.83'
Nail & K.C. remon. tag on NW side 22" Maple N 44° E 122.70'
Nail & K.C. remon. tag on NE side 22" Oak S 63° E 152.68'
Nail & K.C. remon. tag on W side 12" Oak N 00° W 91.98'
Nail & K.C. remon. tag on NW side 20" Poplar N 40° W 139.73'
Capped iron #31614 N 00° W 80.91'
C/L of bit. road running E-W, North 6.3'
On fence line running S

P.A. 345 1990 KENT COUNTY

PEER APPROVED 2/25/99

CHAIRMAN *[Signature]*

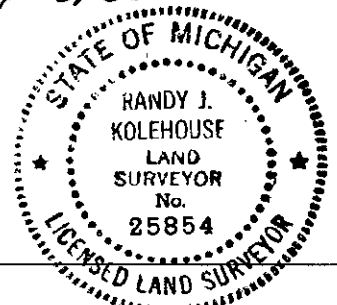

Signed by *[Signature]*
EARTH TECH

Date 3/20/99

Surveyor's Michigan License No. 25854