

KENT COUNTY REMONUMENTATION

JAN 24 1996

COMMISSION

LAND CORNER RECORDATION CERTIFICATE

Filing Requirement of Act 74, Mich. P.A. 1970

For corners in KENT COUNTY (County)

Located In:


Corner Code #

1. Public Land Survey	T	9N	R	10W	J-6
	T		R		
	T		R		
	T		R		
2. Property Controlling in Section	S	T	R		
	S	T	R		
3. Miscellaneous	S	T	R		
Property in Section	S	T	R		

STATE OF MICHIGAN  
 COUNTY OF KENT  
 RECEIVED FOR RECORD  
 95 OCT 24 PM 4:13  
 REG. OF DEEDS  
 8719

Register of Deeds Stamp & File Number

- 4. Lot No. \_\_\_\_\_, Recorded Plat \_\_\_\_\_
- 5. Private Claims \_\_\_\_\_

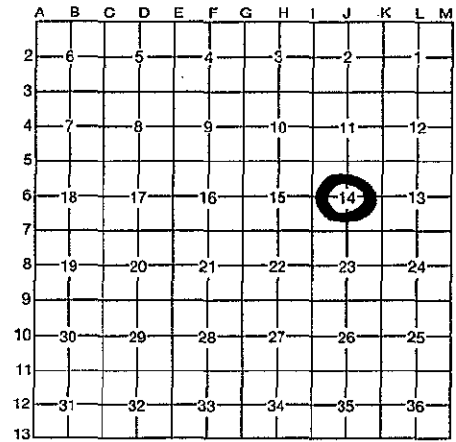

I, Kirk Breitels, in a field survey on Sept. 17, 19 95, do hereby certify that under requirements of P.A. 74, Michigan P.A. of 1970, the corner points mentioned in lines 1 and 2 above were in conformance with regulations and rules therefore as required in the current manual of survey instructions of the United States Department of the Interior, Bureau of Land Management or by a decree of a Court of Law and/or that the corner points mentioned in lines 3, 4 and 5 above were in conformance with the rules of the Michigan Board of Professional Surveyors or by a Decree of a Court of Law; established, re-established, monumented, re-monumented, recovered, found as expressed below:

NOTE: Not more than 4 corners, all in the same town and range, may be recorded on this certificate.

A. Description of original monument and accessories and/or subsequent restoration:

J-6 1837 GLO Not Set  
 1902 Williams & Works Stake & Stone 2626' W. of E 1/4 corner  
 (Meas. 2658' N. of S 1/4 corner to "correct E-W 1/4 line)

P.A. 345 1990 KENT COUNTY  
 PEER APPROVED 9/28/95  
 CHAIRMAN Harry Huber

B. Description of corner evidence found and/or method applied in restoring or reestablishing corner:

J-6 Found Spike on the North side of a 30" Oak tree that has remains of fence N-S-E-W through it. Said Spike is 1.7' W. & 3.0' N. of intersection of 1/4 lines. There is no research or documentation in regards to the Spike being the C 1/4 corner of Sec. 14. Survey notes by Glaza & Assoc. in 1990 show E-W 1/4 line as running between the W 1/4 & E 1/4 corners. Survey notes by All Points Surveyors, Inc. use intersection of 1/4 lines as the C 1/4 corner (not set). Computed the intersection of 1/4 lines and found it to be 2624.23' West (2626 W&W 1902) of the East 1/4 corner and 2658.72' North (2658' W&W 1902) of the South 1/4 corner of Sec. 14. Location of the intersection of 1/4 lines fall on a root at the Southeast side of aforementioned 30" Oak tree.

The Intersection of 1/4 lines is accepted by me and is generally accepted by professional surveyors as the best available evidence of the position of the corner.

C. Description of monument for corner and accessories established to perpetuate locating the position of the corner:

- J-6 Set Rerod and "Kent Co. Remon." cap in root on the SE side of a 30" Oak tree.
- Set Nail & KC Remon. tag N. side 15" Oak N80°E 23.12'
- Set Nail & KC Remon. tag SE side 10" Maple N30°E 16.41'
- Set Nail & KC Remon. tag E. side 30" Oak S20°E 28.03'
- Set Nail & KC Remon. tag SE side 20" Oak S40°W 16.89'
- Set Nail & KC Remon. tag S. side 12" Maple S88°W 7.63'



Signed by Kirk Breitels  
 30077

Date 10/20/95

Surveyor's Michigan License No. \_\_\_\_\_