

MAY 22 2000

LAND CORNER RECORDATION CERTIFICATE
Filing Requirement of Act 74, Mich. P.A. 1970
KENT COUNTY REMONUMENTATION

SECTION

For corners in

Kent (County)	Located in: Courtland Township	Corner Code #
1. Public Land Survey	T <u>9N</u> R <u>10W</u>	<u>J-7</u>
	T _____ R _____	_____
	T _____ R _____	_____
	T _____ R _____	_____
2. Property Controlling in Section	S _____ T _____ R _____	_____
	S _____ T _____ R _____	_____
3. Miscellaneous Property in Sec.	S _____ T _____ R _____	_____
	S _____ T _____ R _____	_____

REG. OF DEEDS

[Handwritten Signature]

STATE OF MICHIGAN
COUNTY OF KENT
RECEIVED FOR RECORD
1999 OCT 15 AM 8:06


11352

Register of Deeds Stamp & File Number

- 4. Lot No. _____, Recorded Plat _____
- 5. Private Claims _____

I, Randy Kolehouse, in a field survey on January 18 19 99, do hereby certify that under requirements of P.A. 74 Michigan P.A. of 1970, the corner points mentioned in lines 1 and 2 above were in conformance with regulations and rules therefore as required in the current manual of survey instructions of the United States Department of the interior, Bureau of Land Management or by a decree of a Court of Law and/or that the corner points mentioned in lines 3, 4 and 5 above were in conformance with the rules of the Michigan Board of Land Surveyors or by a Decree of a Court of Law; established, re-established, monumented, re-monumented, recovered, found as expressed below:

NOTE: Not more than 4 corners, all in the same town and range, may be recorded on this certificate.

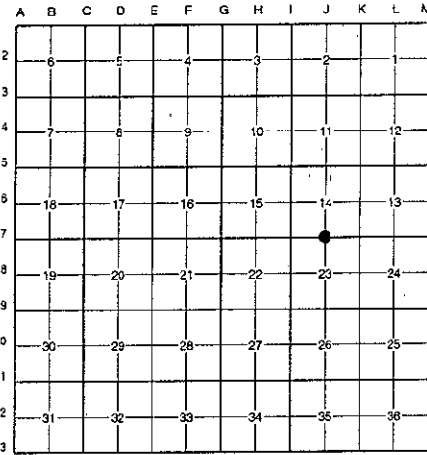

A. Description of original monument and accessories and/or subsequent restoration:

J-7	1837	G.L.O. Notes	Cathcart	Set Post	P.A. 345 1990 KENT COUNTY PEER APPROVED CHAIRMAN <i>[Signature]</i>
	1902	Notes	Williams & Works	Set Stake	
	1983	L.C.R.C. #3596	William Byl	Set K.C. Monument	
	1991	L.C.R.C. #6240	C. Marschall	K.C. Monument	

This corner was originally approved by the Kent County Remonumentation Peer Group and monumented by William Byl on 9/2/83 and was recorded per L.C.R.C. #3596.

B. Description of corner evidence found and/or method applied in restoring or reestablishing corner:

J-7 Found a Standard Kent County Monument on the C/L of 13 Mile Road (bit.) running East and West, on line of a tree row running North and South, per L.C.R.C.'s #3596 and #6240 as set by William Byl which checked the 1902 notes of Williams & Works.

L.C.R.C. #3596

SW cor. Foundation, Hse. #8249 n 75° E 203.40
Nail & tag, E sd. 36" Oak N 00 E 6147'
Nail & tag, N sd. 18" Oak N 60 W 60.75'
Nail & tag, N sd. 18" Oak N 00 W 4.78'
Capped iron

L.C.R.C. #6240

Nail & Remon tag in NE sd. 22" Oak N 64 W 60.68'
Nail & Remon tag in W sd. 24" Walnut N 35 W 28.69' (m. 28.69')
Nail & Remon tag in E sd. 60" Oak N 0 W 61.37'
Nail & Remon tag in NE sd. 42" Oak N 73 W 91.80' (m. 91.78')
Nail & Remon tag in NE sd. 24" Oak N 78 W 118.07'
Capped 1/2" Rerod N 4.80'

The selected location is accepted by me and is generally accepted by professional surveyors as the best available evidence of the position of the original corner.

C. Description of monument for corner and accessories established to perpetuate locating the position of the corner:

J-7 Standard Kent County Monument

Nail & K.C. remon. tag on NE side 26" Oak N 78° W 118.07'
Nail & K.C. remon. tag on NE side 42" Oak N 73° W 91.78'
Nail & K.C. remon. tag on W side 24" Walnut N 35° W 28.69'
Nail & K.C. remon. tag on NE side 26" Oak N 64° W 60.68'
Nail & K.C. remon. tag on E side 60" Oak North 61.37'
Capped iron North 4.80'

SW cor. fndn. Hse. #8249 N 75° E 203.40'
On C/L of bit. road running E-W
On tree row running N-S

Signed by

[Handwritten Signature]
EARTH TECH

Date

3/30/99

Surveyor's Michigan License No.

25854

