

MAY 22 2000

1/2

SECTION

LAND CORNER RECORDATION CERTIFICATE  
Filing Requirement of Act 74, Mich. P.A. 1970  
KENT COUNTY REMONUMENTATION

For corners in

Kent (County)	Located in:	Courtland Township	Corner Code #
1. Public Land Survey,	T <u>9N</u>	R <u>10W</u>	<u>J-9</u>
	T _____	R _____	_____
	T _____	R _____	_____
	T _____	R _____	_____
2. Property Controlling in Section	S _____	T _____	R _____
	S _____	T _____	R _____
3. Miscellaneous Property in Sec.	S _____	T _____	R _____
	S _____	T _____	R _____

REG. OF DEEDS

*[Signature]*

STATE OF MICHIGAN  
COUNTY OF KENT  
RECEIVED FOR RECORD  
1999 OCT 15 AM 8:06

11353

Register of Deeds Stamp & File Number


- 4. Lot No. \_\_\_\_\_, Recorded Plat \_\_\_\_\_
- 5. Private Claims \_\_\_\_\_

I, Randy Kolehouse, in a field survey on January 18 19 99, do hereby certify that under requirements of P.A. 74 Michigan P.A. of 1970, the corner points mentioned in lines 1 and 2 above were in conformance with regulations and rules therefore as required in the current manual of survey instructions of the United States Department of the interior, Bureau of Land Management or by a decree of a Court of Law and/or that the corner points mentioned in lines 3, 4 and 5 above were in conformance with the rules of the Michigan Board of Land Surveyors or by a Decree of a Court of Law; established, re-established, monumented, re-monumented, recovered, found as expressed below:

**NOTE:** Not more than 4 corners, all in the same town and range, may be recorded on this certificate.

A. Description of original monument and accessories and/or subsequent restoration:

J-9	1837	G.L.O. Notes	Cathcart	Set Post
	1970	Witness Map	K.C. Surveyor	3/4" Iron
	1984	L.C.R.C. #3783	William Byl	Fnd. Iron Pipe / Set K.C. Monument
	1991	L.C.R.C. #6239	C. Marschall	K.C. Monument

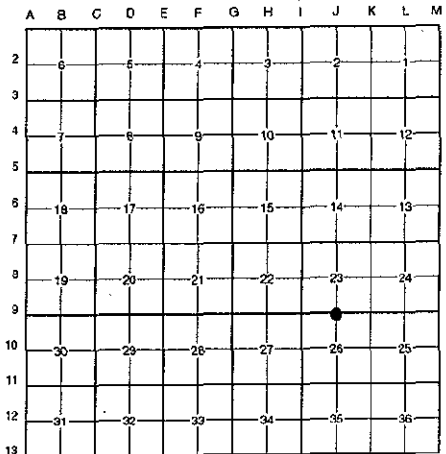

This corner was originally approved by the Kent County Remonumentation Peer Group and monumented by William Byl on 3/19/84 and was recorded per L.C.R.C. #3783.

B. Description of corner evidence found and/or method applied in restoring or reestablishing corner:

J-9 Found a Standard Kent County Monument at the intersection of old fence lines running North, South and West per L.C.R.C.'s #3783 and #6239 as set by William Byl in place of a 1" x 24" iron pipe he found on the East side of a fence post which checked the K.C. Surveyor's records.

L.C.R.C. #3783

Nail & tag, E. sd. 36" W. Cherry North 54.50'  
Nail & tag, W. sd. 12" W. Cherry South 39.95'  
Nail & tag, W. sd. 20" W. Cherry South 113.95'

L.C.R.C. #6239

On FNC line to N & S & to the West  
Nail & Tag E sd. 6" Cherry S 05° E 2.74' (m. 2.66')  
Nail & Tag W sd. 22" Maple North 30.26' (m. 30.32')  
Nail & Tag W sd. 14" Cherry South 39.93' (m. 40.04')  
Nail & Tag NE sd. 4" Cherry N 45 W 10.55' (m. 10.57')

The selected location is accepted by me and is generally accepted by professional surveyors as the best available evidence of the position of the original corner.

C. Description of monument for corner and accessories established to perpetuate locating the position of the corner:

J-9 Standard Kent County Monument

Nail & K.C. remon. tag on W side 20" Cherry South 40.04'  
Nail & K.C. remon. tag on NE side 6" Cherry N 45° W 10.57'  
Nail & K.C. remon. tag on W side 24" Maple North 30.32'  
Nail & K.C. remon. tag on E side 8" Cherry S 05° E 2.66'  
At "X" of old fence lines running N-S-W

P.A. 345 1990 KENT COUNTY

PEER APPROVED 2/25/99  
CHAIRMAN [Signature]

Signed by [Signature]  
EARTH TECH

Date 3/30/99

Surveyor's Michigan License No. 25854

