

SURVEY & REMONUMENTATION

MAR 03 1998

\$7.00
\$2.00
For corners in

SECTION

LAND CORNER RECORDATION CERTIFICATE
Filing Requirement of Act 74, Mich. P.A. 1970
KENT COUNTY REMONUMENTATION

For corners in	Kent (County)	Located in: Courtland Township	Corner Code #
1. Public Land Survey		T <u>9N</u> R <u>10W</u>	<u>J-13</u>
		T _____ R _____	_____
		T _____ R _____	_____
		T _____ R _____	_____
2. Property Controlling in Section	S _____	T _____ R _____	_____
	S _____	T _____ R _____	_____
3. Miscellaneous Property in Sec.	S _____	T _____ R _____	_____
	S _____	T _____ R _____	_____
4. Lot No. _____, Recorded Plat _____			
5. Private Claims _____			

STATE OF MICHIGAN
COUNTY OF KENT
RECEIVED FOR RECORD

97 NOV 14 AM 9:01

REG. OF DEEDS
[Signature]

10327

Register of Deeds Stamp & File Number

I, Randy Kolehouse, in a field survey on July 14 19 97, do hereby certify that under requirements of P.A. 74 Michigan P.A. of 1970, the corner points mentioned in lines 1 and 2 above were in conformance with regulations and rules therefore as required in the current manual of survey instructions of the United States Department of the interior, Bureau of Land Management or by a decree of a Court of Law and/or that the corner points mentioned in lines 3, 4 and 5 above were in conformance with the rules of the Michigan Board of Land Surveyors or by a Decree of a Court of Law; established, re-established, monumented, re-monumented, recovered, found as expressed below:

A	B	C	D	E	F	G	H	I	J	K	L	M
2	6	5	4	3	2	1						
3												
4	7	8	9	10	11	12						
5												
6	18	17	16	15	14	13						
7												
8	19	20	21	22	23	24						
9												
10	30	29	28	27	26	25						
11												
12	31	32	33	34	35	36						
13												

NOTE: Not more than 4 corners, all in the same town and range, may be recorded on this certificate.

A. Description of original monument and accessories and/or subsequent restoration:

J-13	1831	G.L.O. Notes	Mullett	Set Post
	1981	L.C.R.C. #2043	Glaza and Associates	1" Dia. Pipe
	1982	L.C.R.C. #2877	Jonker Land Surveys	Fnd. 1" Dia. Pipe / Set K.C. Monument
	1991	L.C.R.C. #6238	Chris Marschall	K.C. Monument

P.A. 345 1990 KENT COUNTY
PEER APPROVED 7/24/97
[Signature]
CHAIRMAN

Note: This corner is not common with J-1, T8N, R10W.

This corner was originally approved by the Kent County Remonumentation Peer Group and monumented by Rob Jonker on 5/24/82 and was recorded per L.C.R.C. #2877.

B. Description of corner evidence found and/or method applied in restoring or reestablishing corner:

J-13 Found a Standard Kent County Monument 3' North of the C/L of 10 Mile Road (bit.) running East and West on line of a tree row running North per L.C.R.C.'s #2877 and #6238 as set by Rob Jonker in place of a 1" diameter pipe he found which checked L.C.R.C. #2043.


L.C.R.C. #2877	L.C.R.C. #6238
Remon. tag on NW side 14" Sassafras N35°E 54.53'	Nail & Tag NW sd. 18" Sassafras N 35 E 54.49'
Remon. tag on E side 9" W.Cherry N0°E 39.18'	Nail & Tag SE sd. 14" Oak N 51 E 77.25'
Remon. tag on N side t.pole S70°E 104.70'	Nail & Tag E sd. 14" W. Cherry N 04 E 39.25'
Remon. tag on N side t.pole S80°W 185.13'	Nail & Tag E sd. 42" Oak N 06 W 22.36'
1/2" iron in mon. box, east 103.34'	Mon. I-1 8N-10W N 90 E 103.31'

The selected location is accepted by me and is generally accepted by professional surveyors as the best available evidence of the position of the original corner.

C. Description of monument for corner and accessories established to perpetuate locating the position of the corner:

J-13 Standard Kent County Monument

Nail & K.C. remon. tag on NW side 18" Sassafras N 35° E 54.49'
Nail & K.C. remon. tag on SE side 14" Oak N 51° E 77.25'
Nail & K.C. remon. tag on E side 14" W. Cherry N 04° E 39.25'
Nail & K.C. remon. tag on E side 42" Oak N 06° W 22.36'
K.C. Mon., J-1, T8N, R10W, East 103.31'

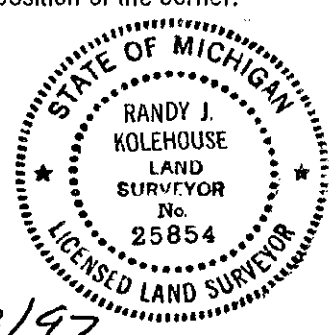

Signed by *Randy J. Kolehouse* Date 9/23/97
EARTH TECH

Surveyor's Michigan License No. 25854