

MAY 22 2000

LAND CORNER RECORDATION CERTIFICATE
Filing Requirement of Act 74, Mich. P.A. 1970
KENT COUNTY REMONUMENTATION

For corners in

SECTION

Kent (County)	Located in: Courtland Township	Corner Code #
1. Public Land Survey	T <u>9N</u> R <u>10W</u>	<u>K-1</u>
	T _____ R _____	_____
	T _____ R _____	_____
	T _____ R _____	_____
2. Property Controlling in Section	S _____ T _____ R _____	_____
	S _____ T _____ R _____	_____
3. Miscellaneous Property in Sec.	S _____ T _____ R _____	_____
	S _____ T _____ R _____	_____

REG. OF DEEDS

[Signature]

STATE OF MICHIGAN
COUNTY OF KENT
RECEIVED FOR RECORD
1999 OCT 15 AM 8:06

11358

Register of Deeds Stamp & File Number


4. Lot No. _____, Recorded Plat _____
5. Private Claims _____

I, Randy Kolehouse, in a field survey on February 10 19 99, do hereby certify that under requirements of P.A. 74 Michigan P.A. of 1970, the corner points mentioned in lines 1 and 2 above were in conformance with regulations and rules therefore as required in the current manual of survey instructions of the United States Department of the interior, Bureau of Land Management or by a decree of a Court of Law and/or that the corner points mentioned in lines 3, 4 and 5 above were in conformance with the rules of the Michigan Board of Land Surveyors or by a Decree of a Court of Law; established, re-established, monumented, re-monumented, recovered, found as expressed below:

NOTE: Not more than 4 corners, all in the same town and range, may be recorded on this certificate.

A. Description of original monument and accessories and/or subsequent restoration:

K-1	1837	G.L.O. Notes	Cathcart	Set Post
	1909	Notes	Williams & Works	Stake and Small Stones
	1972	L.C.R.C. #187	Williams & Works	Iron Above Ring of Stones
	1979	L.C.R.C. #1280	G. Hackbardt	"T" Iron
	1986	L.C.R.C. #4449	R. Kolehouse	Fnd. "T" Iron / Set K.C. Monument

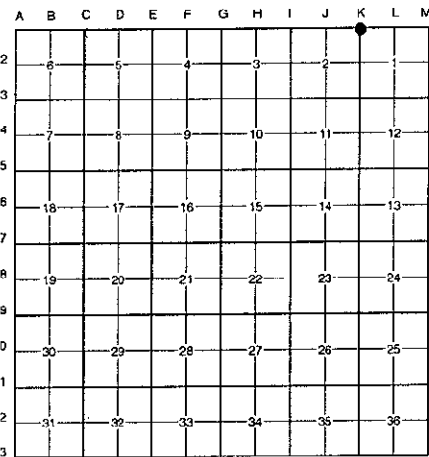

Note: This corner is not common with K-13, T10N, R10W.

This corner was originally approved by the Kent County Remonumentation Peer Group and monumented by Randy Kolehouse May of 1986 and was recorded per L.C.R.C. #4449.

B. Description of corner evidence found and/or method applied in restoring or reestablishing corner:

K-1 Found a Standard Kent County Monument (on the Township line) 2.0' ± South of 16 mile Road (gravel) running East and West, on line of a fence line and tree row running South, per L.C.R.C. #4449 as set by Randy Kolehouse on the Township line 1.98' South of a "T" iron which checked L.C.R.C.'s #1280, #187 and the 1909 notes of Williams & Works.

L.C.R.C. #4449

- Nail & K.C. Remon tag in E. side 8" Oak N 55° W 39.35' (m. 39.36')
- Nail & K.C. Remon tag in W. side 12" Oak N 25° E 22.22' (m. 22.18')
- Nail & K.C. Remon tag in N. side Twin 8" Oak S 50° E 53.60' (m. 53.53')
- Nail & K.C. Remon tag in E. side Twin 14" W. Cherry S 15° W 24.94' (m. 24.87')
- Nail & K.C. Remon tag in N. side 8" Twin Oak S 60° W 43.50'
- "T" iron North 1.98' (m. 1.97')
- K.C. Mon. at SE cor. sec. 35 T10N R10W West 239.4' (m. 239.48')

P.A. 345 1990 KENT COUNTY
PEER APPROVED 2/25/99
CHAIRMAN [Signature]

The selected location is accepted by me and is generally accepted by professional surveyors as the best available evidence of the position of the original corner.

C. Description of monument for corner and accessories established to perpetuate locating the position of the corner:

K-1 Standard Kent County Monument

- | | |
|--|--|
| Nail & K.C. remon. tag on E side 8" Oak N 55° W 39.36' | "T" iron North 1.97' |
| Nail & K.C. remon. tag on W side 12" Oak N 25° E 22.18' | C/L of gravel road running E-W, North 2.0' ± |
| Nail & K.C. remon. tag on N side twin 8" Oak S 50° W 53.53' | On fence line and tree row running S |
| Nail & K.C. remon. tag on E side twin 14" W. Cherry S 15° W 24.87' | K.C. Mon., K-13, T10N, R10W, West 239.48' |
| Nail & K.C. remon. tag on N side twin 8" Oak S 60° W 43.50' | |
| Capped rebar #31604 S 00° E 33.07' | |

Signed by Randy J. Kolehouse
EARTH TECH

Date 3/30/99

Surveyor's Michigan License No. 25854

