

11/2

MAY 22 2000

SECTION

LAND CORNER RECORDATION CERTIFICATE
Filing Requirement of Act 74, Mich. P.A. 1970
KENT COUNTY REMONUMENTATION

For corners in

Kent (County)	Located in:	Courtland Township	Corner Code #
1. Public Land Survey	T <u>9N</u>	R <u>10W</u>	<u>K-2</u>
	T _____	R _____	_____
	T _____	R _____	_____
	T _____	R _____	_____
2. Property Controlling in Section	S _____	T _____	R _____
	S _____	T _____	R _____
3. Miscellaneous Property in Sec.	S _____	T _____	R _____
	S _____	T _____	R _____

REG. OF DEEDS

[Signature]

STATE OF MICHIGAN
COUNTY OF KENT
RECEIVED FOR RECORD
1999 OCT 15 AM 8:06

11359

Register of Deeds Stamp & File Number


- 4. Lot No. _____, Recorded Plat _____
- 5. Private Claims _____

I, Randy Kolehouse, in a field survey on February 1 19 99, do hereby certify that under requirements of P.A. 74 Michigan P.A. of 1970, the corner points mentioned in lines 1 and 2 above were in conformance with regulations and rules therefore as required in the current manual of survey instructions of the United States Department of the interior, Bureau of Land Management or by a decree of a Court of Law and/or that the corner points mentioned in lines 3, 4 and 5 above were in conformance with the rules of the Michigan Board of Land Surveyors or by a Decree of a Court of Law; established, re-established, monumented, re-monumented, recovered, found as expressed below:

NOTE: Not more than 4 corners, all in the same town and range, may be recorded on this certificate.

A. Description of original monument and accessories and/or subsequent restoration:

K-2	1837	G.L.O. Notes	Cathcart	Set Post
	1938	Witness Map	K.C. Surveyor	Stone
	1972	L.C.R.C. #127	M. Chambers	1/8" Rod & Spike
	1979	L.C.R.C. #1280	G. Hackbardt	Concrete Monument
	1982	L.C.R.C. #3048	Jonker Land Survey	Fnd. 1/8" Rod & Conc. Mon. / Set K.C. Monument
	1991	L.C.R.C. #6236	C. Marschall	K.C. Monument

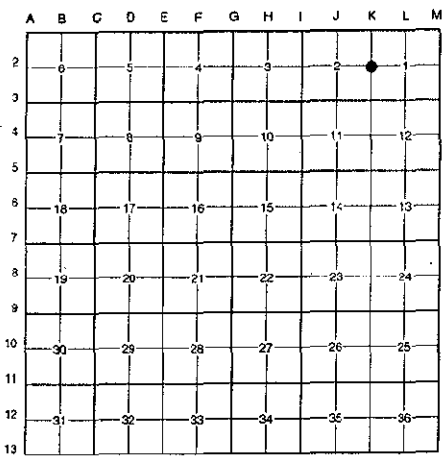

This corner was originally approved by the Kent County Remonumentation Peer Group and monumented by Rob Jonker on 8/2/82 and was recorded per L.C.R.C. #3048.

B. Description of corner evidence found and/or method applied in restoring or reestablishing corner:

K-2 Found a Standard Kent County Monument 3.0' South of the C/L of Benham Road (gravel) running East and West, on line of a tree row running South, per L.C.R.C.'s #3048 and #6236 as set by Rob Jonker in place of a 1/8" rod he found on top of a 4" x 24" concrete monument 12" below grade which checked L.C.R.C.'s #1280 and #127.

L.C.R.C. #3048

L.C.R.C. #6236

Remon. tag on NE side 22" Maple N30°W 29.76'
 Remon. tag on W side 30" Oak N15°E 40.00'
 Remon. tag on NW side 30" Maple N50°E 37.15'
 Remon. tag on E side 40" Tri.Basswood S0°E 37.36'

Nail & Tag in NE side 26" Maple N 30 W 29.78' (m. 29.79')
 Nail & Tag in W side 32" Oak N 15 E 39.95' (m. 40.00')
 Nail & Tag in NW side 28" Maple N 50 E 37.11' (m. 37.17')
 Nail & Tag in E side 26" Tri Basswood S 0 E 37.35'

The selected location is accepted by me and is generally accepted by professional surveyors as the best available evidence of the position of the original corner.

C. Description of monument for corner and accessories established to perpetuate locating the position of the corner:

K-2 Standard Kent County Monument

Nail & K.C. remon. tag on NE side 26" Maple N 30° W 29.79'
 Nail & K.C. remon. tag on W side 32" Oak N 15° E 40.00'
 Nail & K.C. remon. tag on NW side 28" Maple N 50° E 37.17'
 Nail & K.C. remon. tag on E side 26" triple Basswood S 00° E 37.35'
 C/L of gravel road running E-W, North 3.0'
 On tree row running S

P.A. 345 1990 KENT COUNTY
 PEER APPROVED 2/23/99
 CHAIRMAN [Signature]

Signed by Randy J. Kolehouse Date 2/30/99
 EARTH TECH
 Surveyor's Michigan License No. 25854

