

MAY 22 2000

M/2

SECTION

LAND CORNER RECORDATION CERTIFICATE
Filing Requirement of Act 74, Mich. P.A. 1970
KENT COUNTY REMONUMENTATION

For corners in

Table with columns: Kent (County), Located in: Courtland Township, Corner Code #. Rows include Public Land Survey, Property Controlling in Section, and Miscellaneous Property in Sec.

REG. OF DEEDS

Handwritten signature


STATE OF MICHIGAN
COUNTY OF KENT
RECEIVED FOR RECORD
1999 OCT 15 AM 8:06

11360

Register of Deeds Stamp & File Number

- 4. Lot No. Recorded Plat
5. Private Claims

I, Randy Kolehouse, in a field survey on February 15 19 99, do hereby certify that under requirements of P.A. 74 Michigan P.A. of 1970, the corner points mentioned in lines 1 and 2 above were in conformance with regulations and rules therefore as required in the current manual of survey instructions of the United States Department of the interior, Bureau of Land Management or by a decree of a Court of Law and/or that the corner points mentioned in lines 3, 4 and 5 above were in conformance with the rules of the Michigan Board of Land Surveyors or by a Decree of a Court of Law; established, re-established, monumented, re-monumented, recovered, found as expressed below:

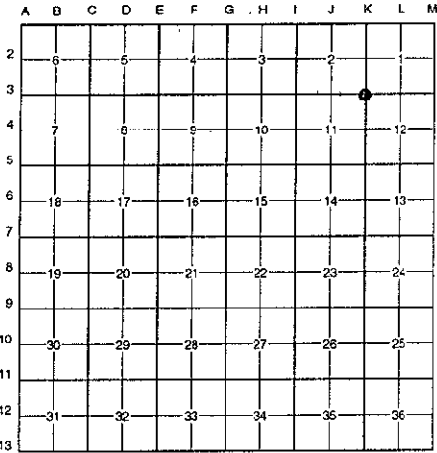

NOTE: Not more than 4 corners, all in the same town and range, may be recorded on this certificate.

A. Description of original monument and accessories and/or subsequent restoration:

Table with columns: Date, G.L.O. Notes, Cathcart, Set Post. Rows list survey dates from 1837 to 1991 and corresponding monument types like Cathcart, Witness Map, K.C. Surveyor, etc.

This corner was originally approved by the Kent County Remonumentation Peer Group and monumented by Randy Kolehouse on 8/3/85 and was recorded per L.C.R.C. #4303.

B. Description of corner evidence found and/or method applied in restoring or reestablishing corner:

K-3 Found a Standard Kent County Monument per L.C.R.C.'s #4303 and #6235 as set by Randy Kolehouse in place of a 1/2" rebar he found in a ring of large stones going to 2.5' below grade which checked a 1985 survey by All-Points Surveyors.

L.C.R.C. #4303

L.C.R.C. #6235

- Nail & K.C. Remon. tag in E. side 22" Maple N 10° W 36.22'
Nail & K.C. Remon. tag in W. side tw 16" Oak N 45° E 22.60'
Nail & K.C. Remon. tag in S. side 6" Ash N 75° W 22.55'
Nail & K.C. Remon. tag in E. side 10" W. Cherry S 15° W 35.45'
Nail & K.C. Remon. tag in SW side 14" Oak S 50° E 19.22'

- Nail & Tag S. sde 8" Ash N 75 W 22.11' (m. 21.83')
Nail & Tag E. sde 18" W. Cherry S 15 W 35.41'
Nail & Tag SW sde 18" Oak S 50 E 19.20'
Nail & Tag W sde Twin 18" Oak N 45 E 22.35' (m. 22.27')
Nail & Tag E sde 24" Maple N 10 W 36.10' (m. 36.08')

The selected location is accepted by me and is generally accepted by professional surveyors as the best available evidence of the position of the original corner.

C. Description of monument for corner and accessories established to perpetuate locating the position of the corner:

K-3 Standard Kent County Monument

- Nail & K.C. remon. tag on S side 8" Ash N 75° W 21.83'
Nail & K.C. remon. tag on E side 18" Cherry S 15° W 35.41'
Nail & K.C. remon. tag on SW side 18" Oak S 50° E 19.20'
Nail & K.C. remon. tag on E side 24" Maple N 10° W 36.08'
Nail & K.C. remon. tag on W side twin 18" Oak N 45° E 22.27'

P.A. 345 1990 KENT COUNTY

PEER APPROVED

CHAIRMAN

Handwritten signature of Randy Kolehouse

Signed by Randy J. Kolehouse EARTH TECH

Date 3/30/99

Surveyor's Michigan License No. 25854

