

MAY 22 2000

LAND CORNER RECORDATION CERTIFICATE
Filing Requirement of Act 74, Mich. P.A. 1970
KENT COUNTY REMONUMENTATION

STATE OF MICHIGAN
COUNTY OF KENT
RECEIVED FOR RECORD
1999 OCT 15 AM 8:07

REG. OF DEEDS

11361

Register of Deeds Stamp & File Number

For corners in

SECTION

Table with columns: Kent (County), Located in: Courtland Township, Corner Code #. Rows include Public Land Survey, Property Controlling in Section, and Miscellaneous Property in Sec.


4. Lot No. Recorded Plat
5. Private Claims

I, Randy Kolehouse, in a field survey on February 5 19 99, do hereby certify that under requirements of P.A. 74 Michigan P.A. of 1970, the corner points mentioned in lines 1 and 2 above were in conformance with regulations and rules therefore as required in the current manual of survey instructions of the United States Department of the Interior, Bureau of Land Management or by a decree of a Court of Law and/or that the corner points mentioned in lines 3, 4 and 5 above were in conformance with the rules of the Michigan Board of Land Surveyors or by a Decree of a Court of Law; established, re-established, monumented, re-monumented, recovered, found as expressed below:

NOTE: Not more than 4 corners, all in the same town and range, may be recorded on this certificate.

A. Description of original monument and accessories and/or subsequent restoration:

Table with columns: K-4, 1837, 1963, 1973, 1980, 1992, G.L.O. Notes, Witness Map, L.C.R.C. #516, L.C.R.C. #1483, L.C.R.C. #6234, Cathcart, K.C. Surveyor, Exxel Engineering, Williams & Works, C. Marschall, Set Post, Stone, Stone, Fnd. Pointed Stone / Set K.C. Monument, K.C. Monument

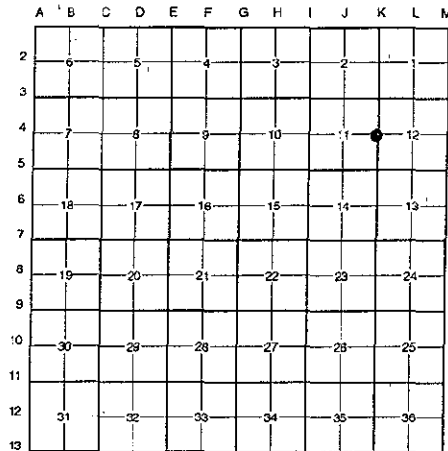

This corner was originally approved by the Kent County Remonumentation Peer Group and monumented by Williams & Works on 11/28/80 and was recorded per L.C.R.C. #1483.

B. Description of corner evidence found and/or method applied in restoring or reestablishing corner:

K-4 Found a Standard Kent County Monument 0.1' below grade on the C/L of Redmond (gravel/bit.) running South and 20.0' ± South of Swift Road (bit.) running West and (gravel) running East per L.C.R.C.'s #1483 and #6234 as set by Williams & Works in place of a pointed stone they found over a wooden post which checked the K.C. Surveyor's records.

L.C.R.C. #1483

L.C.R.C. #6234

K.C.R. Tag & Nail in N Side 12" Basswood Clump N 85°W 16.61'
K.C.R. Tag & Nail in SW Side 28" Maple S 50°E 20.39'
K.C.R. Tag & Nail in N Side 12" Maple N 90°E 53.65'
On C/L Redmond Ave.
20' +/- S of C/L Swift St.

Nail & Tag S sd. 16" Ash S 83 E 38.39' (m. 38.43')
Nail & Tag W sd. P.P. N 01 W 95.98' (m. 95.99')
Nail & Tag N sd. 16" Maple N 88 E 53.80' (m. 53.90')
Nail & Tag N sd. 14" Basswood Clump N 87 W 16.54' (m. 16.56')
Chisled "X" top W. end 15" CMP S 22 W 29.44' (m. 29.45')
20' more or less south of the C/L of Swift St.

The selected location is accepted by me and is generally accepted by professional surveyors as the best available evidence of the position of the original corner.

C. Description of monument for corner and accessories established to perpetuate locating the position of the corner:

K-4 Standard Kent County Monument
Nail & K.C. remon. tag on S side 16" Ash S 83° E 38.43'
Nail & K.C. remon. tag on W side P. pole N 01° E 95.99'
Nail & K.C. remon. tag on N side 16" Maple N 88° E 53.90'
Nail & K.C. remon. tag on N side 14" Basswood clump N 87° W 16.56'
Chiseled "X" top W end 15" CMP S 22° W 29.45'
On C/L of bit./gravel road running S
C/L of bit. road running W and gravel road running E, North 20.0'

P.A. 345 1990 KENT COUNTY

PEER APPROVED 2/25/99
CHAIRMAN Randy Kolehouse

Signed by Randy J. Kolehouse

Date 3/30/99

Surveyor's Michigan License No. 25854

