

MAY 22 2000

SECTION

LAND CORNER RECORDATION CERTIFICATE
Filing Requirement of Act 74, Mich. P.A. 1970
KENT COUNTY REMONUMENTATION

For corners in	Located in:	Courtland Township	Corner Code #
Kent (County)			
1. Public Land Survey	T <u>9N</u> R <u>10W</u>		<u>K-5</u>
	T _____ R _____		_____
	T _____ R _____		_____
	T _____ R _____		_____
2. Property Controlling in Section	S _____ T _____ R _____		_____
	S _____ T _____ R _____		_____
3. Miscellaneous Property in Sec.	S _____ T _____ R _____		_____
	S _____ T _____ R _____		_____
4. Lot No. _____, Recorded Plat _____			
5. Private Claims _____			

REG. OF DEEDS


[Signature]

STATE OF MICHIGAN
COUNTY OF KENT
RECEIVED FOR RECORD
1999 OCT 15 AM 8:07

11362

Register of Deeds Stamp & File Number

I, Randy Kolehouse, in a field survey on February 2 19 99, do hereby certify that under requirements of P.A. 74 Michigan P.A. of 1970, the corner points mentioned in lines 1 and 2 above were in conformance with regulations and rules therefore as required in the current manual of survey instructions of the United States Department of the interior, Bureau of Land Management or by a decree of a Court of Law and/or that the corner points mentioned in lines 3, 4 and 5 above were in conformance with the rules of the Michigan Board of Land Surveyors or by a Decree of a Court of Law; established, re-established, monumented, re-monumented, recovered, found as expressed below:

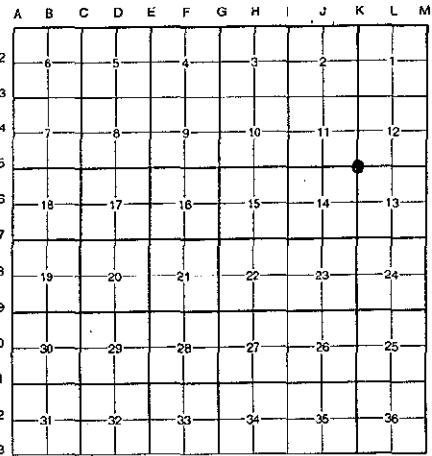

NOTE: Not more than 4 corners, all in the same town and range, may be recorded on this certificate.

A. Description of original monument and accessories and/or subsequent restoration:

K-5	1837	G.L.O. Notes	Cathcart	Set Post
	1963	Witness Map	K.C. Surveyor	Bridge Spike
	1973	L.C.R.C. #516	Exxel Engineering	1/2" Iron
	1982	L.C.R.C. #3047	Jonker Land Survey	Fnd. Road in Mon. Box / Set K.C. Monument
	1991	L.C.R.C. #6233	C. Marschall	K.C. Monument

This corner was originally approved by the Kent County Remonumentation Peer Group and monumented by Rob Jonker on 7/29/82 and was recorded per L.C.R.C. #3047.

B. Description of corner evidence found and/or method applied in restoring or reestablishing corner:

K-5 Found a Standard Kent County Monument 25.0' South of the C/L intersection of M-57 (bit.) running East and West and Redmond Avenue (bit.) running North per L.C.R.C.'s #3047 and #6233 as set by Rob Jonker in place of a 1/2" copperweld rod he found in a monument box which checked L.C.R.C. #516 and the K.C. Surveyor's records.

L.C.R.C. #3047

L.C.R.C. #6233


Remon. tag on SW side p.pole N 40°W 118.4'	Nail & Tag SE sd. Twin 18"-10" Oak S 17 W 58.28' (m. 58.23')
	Nail & Tag W sd. 10" Ash S 33 W 40.02' (m. 40.06')
	Nail & Tag N sd. Twin 10" Oak S 60 W 66.99' (m. 66.97')
	Nail & Tag SW sd. P.P. N 43 W 118.36'
	Mon. is on line to rd. to the North & is South of C/L of E-W rd. more or less 25'

The selected location is accepted by me and is generally accepted by professional surveyors as the best available evidence of the position of the original corner.

C. Description of monument for corner and accessories established to perpetuate locating the position of the corner:

K-5 Standard Kent County Monument
 Nail & K.C. remon. tag on SE side twin 18"-10" Oak S 17° W 58.23'
 Nail & K.C. remon. tag on W side 12" Ash S 33° W 40.06'
 Nail & K.C. remon. tag on N side 10" Oak S 60° W 66.97'
 Nail & K.C. remon. tag on SW side P. pole N 43° W 118.36'
 Nail & K.C. remon. tag on SW side 8" Pine S 43° E 69.36'
 C/L "X" of bit. roads running E-W-N, North 25.0'

P.A. 345 1990 KENT COUNTY
 PEER APPROVED 2/25/99
 CHAIRMAN *[Signature]*

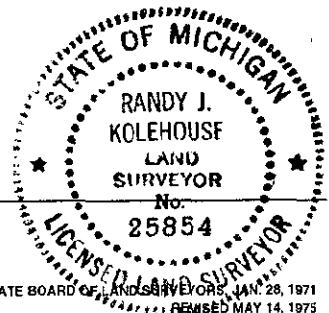

Signed by *[Signature]*
 EARTHTECH

Date 3/30/99

Surveyor's Michigan License No. 25854