

1/2

MAY 22 2000

SECTION

LAND CORNER RECORDATION CERTIFICATE
Filing Requirement of Act 74, Mich. P.A. 1970
KENT COUNTY REMONUMENTATION

For corners in

Kent (County)	Located in: Courtland Township	Corner Code #
1. Public Land Survey	T 9N R 10W	K-6
	T R	
	T R	
	T R	
2. Property Controlling in Section	S T R	
	S T R	
3. Miscellaneous Property in Sec.	S T R	
	S T R	

REG. OF DEEDS

[Signature]

STATE OF MICHIGAN
COUNTY OF KENT
RECEIVED FOR RECORD
1999 OCT 15 AM 8:07


11363

Register of Deeds Stamp & File Number

4. Lot No. _____, Recorded Plat _____
5. Private Claims _____

I, Randy Kolehouse, in a field survey on February 15 19 99, do hereby certify that under requirements of P.A. 74 Michigan P.A. of 1970, the corner points mentioned in lines 1 and 2 above were in conformance with regulations and rules therefore as required in the current manual of survey instructions of the United States Department of the interior, Bureau of Land Management or by a decree of a Court of Law and/or that the corner points mentioned in lines 3, 4 and 5 above were in conformance with the rules of the Michigan Board of Land Surveyors or by a Decree of a Court of Law; established, re-established, monumented, re-monumented, recovered, found as expressed below:

NOTE: Not more than 4 corners, all in the same town and range, may be recorded on this certificate.

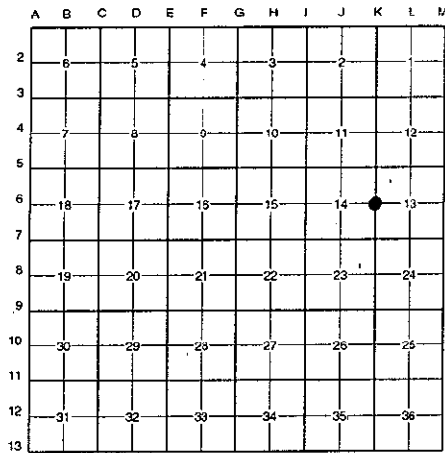

A. Description of original monument and accessories and/or subsequent restoration:

K-6	1837	G.L.O. Notes	Cathcart	Set Post
	1902	Notes	Williams & Works	Flat Stone by Old Stake
	N/A	Witness Map	K.C. Surveyor	Stake
	1983	L.C.R.C. #3568	William Byl	Fnd. Stone & Stake / Set K.C. Monument
	1991	L.C.R.C. #6232	C. Marschall	K.C. Monument

This corner was originally approved by the Kent County Remonumentation Peer Group and monumented by William Byl on 9/1/83 and was recorded per L.C.R.C. #3568.

B. Description of corner evidence found and/or method applied in restoring or reestablishing corner:

K-6 Found a Standard Kent County Monument on the C/L of an old dirt roadbed running North and South per L.C.R.C.'s #3568 and #6232 as set by William Byl in place of a 12" x 12" x 3" stone he found on top of a wood stake and surrounded by 4" to 6" stones which checked the 1902 notes of Williams & Works and the K.C. Surveyor's records.

L.C.R.C. #3568

- Nail & tag, N sd. 15" Maple N 75 W 16.92'
- Nail & tag, N sd. 15" Maple S 55 W 39.88'
- Nail & tag, E sd. 15" Maple S 30 E 79.17'
- Nail & tag, N sd. 8" Maple S 50 E 24.43'

L.C.R.C. #6232

- Nail & Tag N. sd. 18" Maple N 75 W 16.95'
- Nail & Tag N. sd. 16" Maple S 55 W 39.69' (m. 39.50')
- Nail & Tag N. sd. 10" Maple S 50 E 24.39'
- Nail & Tag E. sd. 16" Maple S 30 E 79.11' (m. 79.06')


The selected location is accepted by me and is generally accepted by professional surveyors as the best available evidence of the position of the original corner.

C. Description of monument for corner and accessories established to perpetuate locating the position of the corner:

- K-6 Standard Kent County Monument
- Nail & K.C. remon. tag on N side 18" Maple N 75° W 16.95'
 - Nail & K.C. remon. tag on N side 16" Maple S 55° W 39.50'
 - Nail & K.C. remon. tag on N side 10" Maple S 50° E 24.39'
 - Nail & K.C. remon. tag on E side 16" Maple S 30° E 79.06'
 - Nail & K.C. remon. tag on E side 16" Maple N 30° E 50.95'
 - On C/L of old dirt roadbed running N-S

P.A. 345 1990 KENT COUNTY

PEER APPROVED 2/25/99
CHAIRMAN [Signature]

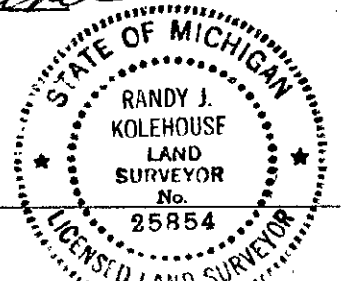

Signed by Randy J. Kolehouse
EARTH TECH

Date 3/2/99

Surveyor's Michigan License No. 25854