

1/2 SURVEY & RECONSTRUCTION

MAY 22 2000

LAND CORNER RECORDATION CERTIFICATE
Filing Requirement of Act 74, Mich. P.A. 1970
KENT COUNTY REMONUMENTATION

SECTION
For corners in Kent (County)

Table with columns: Located in: Courtland Township, Corner Code #, and rows for Public Land Survey, Property Controlling in Section, and Miscellaneous Property in Sec.


STATE OF MICHIGAN
COUNTY OF KENT
RECEIVED FOR RECORD
1999 OCT 15 AM 8:07
REG. OF DEEDS

11366

Register of Deeds Stamp & File Number

4. Lot No. , Recorded Plat
5. Private Claims

I, Randy Kolehouse, in a field survey on February 10 19 99, do hereby certify that under requirements of P.A. 74 Michigan P.A. of 1970, the corner points mentioned in lines 1 and 2 above were in conformance with regulations and rules therefore as required in the current manual of survey instructions of the United States Department of the Interior, Bureau of Land Management or by a decree of a Court of Law and/or that the corner points mentioned in lines 3, 4 and 5 above were in conformance with the rules of the Michigan Board of Land Surveyors or by a Decree of a Court of Law; established, re-established, monumented, re-monumented, recovered, found as expressed below:

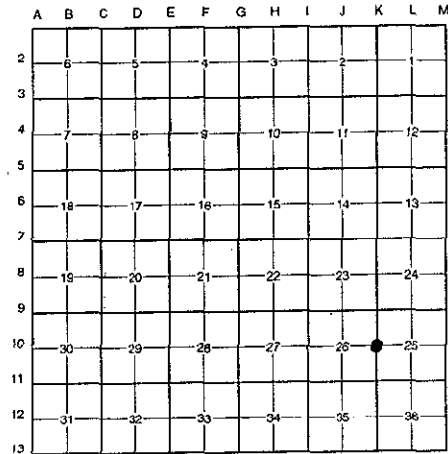

NOTE: Not more than 4 corners, all in the same town and range, may be recorded on this certificate.

A. Description of original monument and accessories and/or subsequent restoration:

Table with 4 columns: K-10, Date, Description, and Monument Type. Rows include G.L.O. Notes, Williams & Works, Jonker Land Survey, and C. Marschall.

This corner was originally approved by the Kent County Remonumentation Peer Group and monumented by Rob Jonker on 7/29/82 and was recorded per L.C.R.C. #3046.

B. Description of corner evidence found and/or method applied in restoring or reestablishing corner:

K-10 Found a Standard Kent County Monument on line of a downed fence line running North, a tree row running West, and 30' ± North of the South edge of the woods line per L.C.R.C.'s #3046 and #6229 as set by Rob Jonker in place of a 1/2" iron he found alongside a boat spike which checked L.C.R.C. #356.

L.C.R.C. #3046

L.C.R.C. #6229

Remon. tag on S side 10" W. Cherry S80°W 7.83'
Remon. tag on N side 12" Ash N90°E 6.33'
Remon. tag on E side 32" Maple N15°W 30.65'
Remon. tag on SE side 8" Maple N25°E 43.36'
On fence line to N thru wood and 30' N of S edge of woods
On line tree line to West

Nail & Tag S sd. 12" W. Cherry S 80 W 7.86' (m. 7.87')
Nail & Tag E sd. 36" Maple N 15 W 30.62' (m. 30.63')
Nail & Tag SE sd. 10" Maple N 25 E 43.32' (m. 43.33')
Nail & Tag N sd. 16" Maple N 90 E 6.84' (m. 6.78')
Nail & Tag E sd. 10" Maple S 20 E 17.48' (m. 17.45')

The selected location is accepted by me and is generally accepted by professional surveyors as the best available evidence of the position of the original corner.

C. Description of monument for corner and accessories established to perpetuate locating the position of the corner:

K-10 Standard Kent County Monument

Nail & K.C. remon. tag on S side 14" Cherry S 80° W 7.87'
Nail & K.C. remon. tag on N side 18" Maple N 90° E 6.78'
Nail & K.C. remon. tag on E side 12" Maple S 20° E 17.45'
Nail & K.C. remon. tag on E side 36" Maple N 15° W 30.63'
Nail & K.C. remon. tag on SE side 10" Maple N 25° E 43.33'
On downed fence line running N
On tree row running W

P.A. 345 1990 KENT COUNTY
PEER APPROVED 2/25/99
CHAIRMAN [Signature]

Signed by [Signature]
EARTH TECH

Date 3/30/99

Surveyor's Michigan License No. 25854

