

MAY 22 2000

SECTION

LAND CORNER RECORDATION CERTIFICATE
Filing Requirement of Act 74, Mich. P.A. 1970
KENT COUNTY REMONUMENTATION


For corners in

Table with columns: Kent (County), Located in: Courtland Township, Corner Code #. Rows include Public Land Survey, Property Controlling in Section, and Miscellaneous Property in Sec.

Register of Deeds Stamp & File Number. Includes stamp: STATE OF MICHIGAN COUNTY OF KENT RECEIVED FOR RECORD 1999 OCT 15 AM 8:07 and handwritten file number 11367.

- 4. Lot No. , Recorded Plat
5. Private Claims

I, Randy Kolehouse, in a field survey on February 18, 1999, do hereby certify that under requirements of P.A. 74 Michigan P.A. of 1970, the corner points mentioned in lines 1 and 2 above were in conformance with regulations and rules therefore as required in the current manual of survey instructions of the United States Department of the Interior, Bureau of Land Management or by a decree of a Court of Law and/or that the corner points mentioned in lines 3, 4 and 5 above were in conformance with the rules of the Michigan Board of Land Surveyors or by a Decree of a Court of Law; established, re-established, monumented, re-monumented, recovered, found as expressed below:

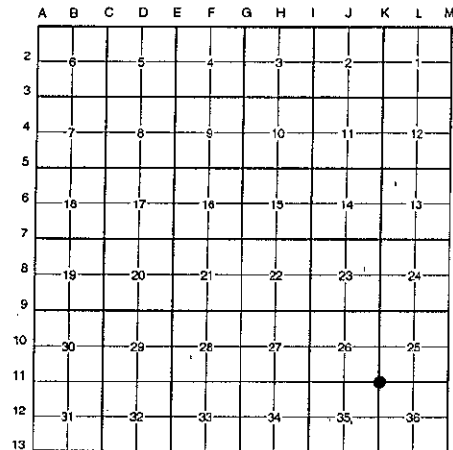

NOTE: Not more than 4 corners, all in the same town and range, may be recorded on this certificate.

A. Description of original monument and accessories and/or subsequent restoration:

Table with columns: K-11, 1837, 1974, 1979, 1995, G.L.O. Notes, L.C.R.C. #626, #1255, #8758, Cathcart, D. South, Williams & Works, Kirk Breitels, Set Post, 1" Iron, 1-1/2" Solid Iron, Fnd. Iron / Set K.C. Monument

This corner was originally approved by the Kent County Remonumentation Peer Group and monumented by Williams & Works on 3/21/79 and was recorded per L.C.R.C. #8758.

B. Description of corner evidence found and/or method applied in restoring or reestablishing corner:

K-11 Found a Standard Kent County Monument 2.0' ± North of the C/L of 11 Mile Road (gravel) running East and West, opposite a 3" diameter steel fence post to the South, per L.C.R.C. #8758 as set by Kirk Breitels in place of a solid iron he found which checked L.C.R.C.'s #1255. (Note: Rebar set in L.C.R.C. #626 is 11.61' East.)

L.C.R.C. #8758

- SE cor. barn (stone fnd.) N55°W 171.55' (m. 171.40')
E'ly face steel fence post (E. gate post) N70°W 85.17' (m. 85.12')
Top C/L N. end culv. N85°E 70.20' (m. 70.09')
Nail & KC Remon. tag N. side 24" Willow S70°E 83.20' (m. 83.12')
N. face steel fence post S00°E 31.96' (m. 31.93')
Rerod - East 11.60' (m. 11.61')

P.A. 345 1980 KENT COUNTY

PEER APPROVED 2/25/99


CHAIRMAN [Signature]

The selected location is accepted by me and is generally accepted by professional surveyors as the best available evidence of the position of the original corner.

C. Description of monument for corner and accessories established to perpetuate locating the position of the corner:

K-11 Standard Kent County Monument

- C/L conc. culv. N 85° E - Chiseled "X" on top conc. culvert 70.09'
SE cor. barn (stone end) N 55° W 171.40'
E'ly face steel fence post (E gate post) N 70° W 85.12'
Nail & K.C. remon. tag on N side 24" Willow S 70° E 83.12'
N face steel fence post S 00° E 31.93'
Nail & K.C. remon. tag on NW side 16" Locust S 30° W 68.62'
Rebar East 11.61'
C/L of gravel road running E-W, South 2.0' ±

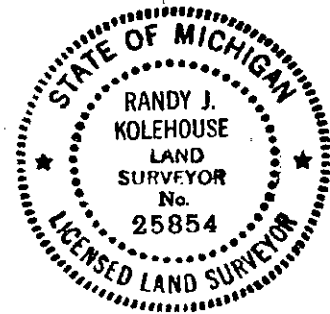

Signed by [Signature] EARTH TECH

Date 3/30/99

Surveyor's Michigan License No. 25854