

MAY 22 2000

SECTION

LAND CORNER RECORDATION CERTIFICATE
Filing Requirement of Act 74, Mich. P.A. 1970
KENT COUNTY REMONUMENTATION

For corners in

Table with columns: Kent (County), Located in: Courtland Township, Corner Code #. Rows include Public Land Survey, Property Controlling in Section, and Miscellaneous Property in Sec.

REG. OF DEEDS


Handwritten signature

STATE OF MICHIGAN
COUNTY OF KENT
RECEIVED FOR RECORD
1999 OCT 15 AM 8:07

11368

Register of Deeds Stamp & File Number

- 4. Lot No. , Recorded Plat
5. Private Claims

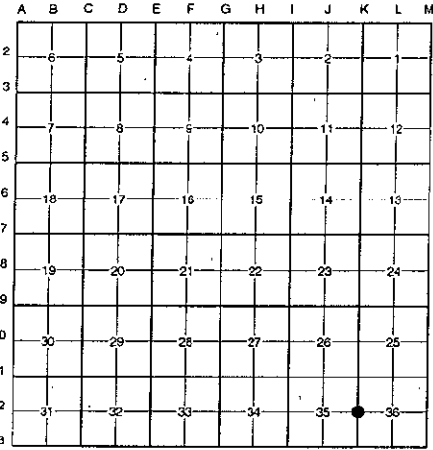

I, Randy Kolehouse, in a field survey on January 29 19 99, do hereby certify that under requirements of P.A. 74 Michigan P.A. of 1970, the corner points mentioned in lines 1 and 2 above were in conformance with regulations and rules therefore as required in the current manual of survey instructions of the United States Department of the interior, Bureau of Land Management or by a decree of a Court of Law and/or that the corner points mentioned in lines 3, 4 and 5 above were in conformance with the rules of the Michigan Board of Land Surveyors or by a Decree of a Court of Law; established, re-established, monumented, re-monumented, recovered, found as expressed below:

NOTE: Not more than 4 corners, all in the same town and range, may be recorded on this certificate.

A. Description of original monument and accessories and/or subsequent restoration:

Table with 4 columns: Year (1837, 1974, 1980, 1991), Description (G.L.O. Notes, L.C.R.C. #624, #1723, #6228), Name (Cathcart, D. South, Williams & Works, C. Marschall), and Monument Type (Set Post, Stone, Fnd. 'T' Iron Over Stone / Set K.C. Monument, K.C. Monument).

This corner was originally approved by the Kent County Remonumentation Peer Group and monumented by Williams & Works on 12/26/80 and was recorded per L.C.R.C. #1723.

B. Description of corner evidence found and/or method applied in restoring or reestablishing corner:

K-12 Found a Standard Kent County Monument on line of tree rows running North, East and West per L.C.R.C.'s #1723 and #6228 as set by Williams & Works in place of a 'T' iron they found over a stone 2.0' +/- below ground which checked L.C.R.C. #624.

L.C.R.C. #1723

L.C.R.C. #6228

Nail & K.C. Remon. Tag N Side 18" W. Cherry S 70°E 13.15'
Nail and K.C. Remon. Tag S Side 14" Beech N 85°W 2.34'

Nail & Tag N sd. 20" Cherry S 70 E 13.10'
Nail & Tag S sd. 18" Ash N 85 W 2.39' (m. 2.40')
Nail & Tag E sd. 10" Hickory N 20 W 29.41' (m. 29.40')
Nail & Tag SW sd. 18" Oak S 45 E 6.69' (m. 6.65')
Nail & Tag N sd. 12" Maple S 85 W 67.84' (m. 67.82')

The selected location is accepted by me and is generally accepted by professional surveyors as the best available evidence of the position of the original corner.


C. Description of monument for corner and accessories established to perpetuate locating the position of the corner:

K-12 Standard Kent County Monument

Nail & K.C. remon. tag on N side 20" Cherry S 70° E 13.10'
Nail & K.C. remon. tag on S side 18" Ash N 85° W 2.40'
Nail & K.C. remon. tag on E side 10" Hickory N 20° W 29.40'
Nail & K.C. remon. tag on SW side 18" Oak S 45° W 6.65'
Nail & K.C. remon. tag on N side 15" Maple S 85° W 67.82'
On tree rows running N-E-W

P.A. 345 1990 KENT COUNTY

PEER APPROVED 2/25/99
CHAIRMAN Randy Kolehouse

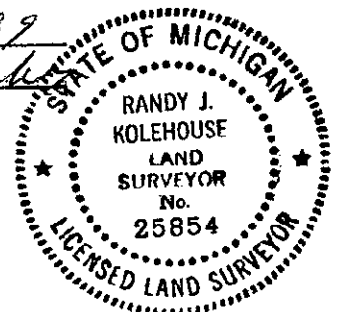

Signed by Randy J. Kolehouse

Date

3/30/99

Surveyor's Michigan License No. 25854