

1/2
MAY 22 2000

LAND CORNER RECORDATION CERTIFICATE
Filing Requirement of Act 74, Mich. P.A. 1970
KENT COUNTY REMONUMENTATION

For corners in SECTION

Kent (County)	Located in:	Courtland Township	Corner Code #
1. Public Land Survey	T <u>9N</u>	R <u>10W</u>	<u>L-1</u>
	T _____	R _____	_____
	T _____	R _____	_____
	T _____	R _____	_____
2. Property Controlling in Section	S _____	T _____	R _____
	S _____	T _____	R _____
3. Miscellaneous Property in Sec.	S _____	T _____	R _____
	S _____	T _____	R _____


STATE OF MICHIGAN
 COUNTY OF KENT
 RECEIVED FOR RECORD
 1999 OCT 15 AM 8:07
 REG. OF DEEDS

11369

Register of Deeds Stamp & File Number

4. Lot No. _____, Recorded Plat _____
 5. Private Claims _____

I, Randy Kolehouse, in a field survey on February 5 19 99, do hereby certify that under requirements of P.A. 74 Michigan P.A. of 1970, the corner points mentioned in lines 1 and 2 above were in conformance with regulations and rules therefore as required in the current manual of survey instructions of the United States Department of the interior, Bureau of Land Management or by a decree of a Court of Law and/or that the corner points mentioned in lines 3, 4 and 5 above were in conformance with the rules of the Michigan Board of Land Surveyors or by a Decree of a Court of Law; established, re-established, monumented, re-monumented, recovered, found as expressed below:

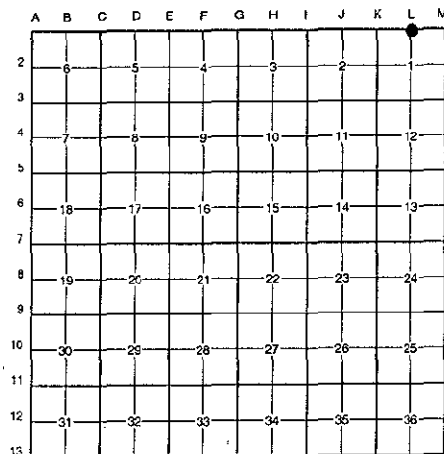

NOTE: Not more than 4 corners, all in the same town and range, may be recorded on this certificate.

A. Description of original monument and accessories and/or subsequent restoration:

L-1 This corner was not originally set by the G.L.O.

Date	Notes	Surveyor	Monument
1876	Notes	Williams & Works	Set Stake
1934	Witness Map	K.C. Surveyor	Iron
1978	L.C.R.C. #1186	J. Reda	3/4" Iron
1986	L.C.R.C. #4440	R. Kolehouse	Fnd. 3/4" Iron / Set K.C. Monument
1988	L.C.R.C. #4793	John Bueche	K.C. Monument

P.A. 345 1990 KENT COUNTY
 PEER APPROVED 2/25/99
 CHAIRMAN [Signature]

Note: This corner is not common with L-13, T10N, R10W.

This corner was originally approved by the Kent County Remonumentation Peer Group and monumented by R. Kolehouse in May of 1986 and was recorded per L.C.R.C. #4440.

B. Description of corner evidence found and/or method applied in restoring or reestablishing corner:

L-1 Found a Standard Kent County Monument 33.0' ± East of the C/L intersection of Crinnon Avenue (gravel) running South and 16 Mile Road (gravel) running East and West per L.C.R.C.'s #4440 and #4793 as set by Randy Kolehouse in place of an old pine root he found 10.2' East of iron shown in L.C.R.C. #1186. The pine root checked the 1876 notes of Williams & Works.

L.C.R.C. #4440

L.C.R.C. #4793

- Nail & K.C. Remon. tag in N. side 18" Maple S 45° W 84.06'
- Nail & K.C. Remon. tag in N. side 30" Oak S 80° W 77.12'
- Nail & K.C. Remon. tag in S. side 10" Elm N 80° W 98.78'
- Nail & K.C. Remon. tag in S. side 8" Elm N 60° W 40.65'
- 3/4" Iron East 10.25'
- K.C. Monument at S 1/4 cor. sec. 36 T10N R10W West 121.8'

- Nail & K.C. Remon tag in N sde 20" Maple S 45 W 84.06' (m. 83.99')
- Nail & K.C. Remon tag in N sde 32" Oak S 80 W 77.12' (m. 77.09')
- Nail & K.C. Remon tag in S sde 12" Elm N 80 W 98.78' (m. 98.63')
- Nail & K.C. Remon. tag in S sde 10" Elm N 60 W 40.65' (m. 40.62)'
- 3/4" Iron East 10.25' (m. 10.15')
- NE cor. sec. East 2520.1'; NW cor. sec. West 2520.2'

The selected location is accepted by me and is generally accepted by professional surveyors as the best available evidence of the position of the original corner.

C. Description of monument for corner and accessories established to perpetuate locating the position of the corner:

L-1 Standard Kent County Monument

- Nail & K.C. remon. tag on N side 20" Maple S 45° W 83.99'
- Nail & K.C. remon. tag on N side 32" Oak S 80° W 77.09'
- Nail & K.C. remon. tag on S side 12" Elm N 80° W 98.63'
- Nail & K.C. remon. tag on S side 10" Elm N 60° W 40.62'
- 3/4" iron pipe East 10.15'

- On C/L of gravel road running E-W
- C/L of gravel road running S, West 33.0'
- K.C. Mon., L-13, T10N, R10W, West 121.98'

Signed by [Signature]
 EARTH TECH

Date 3/30/99

Surveyor's Michigan License No. 25854

