

MAY 22 2000

LAND CORNER RECORDATION CERTIFICATE
Filing Requirement of Act 74, Mich. P.A. 1970
KENT COUNTY REMONUMENTATION

For corners in SECTION

Table with columns: Kent (County), Located in: Courtland Township, Corner Code #. Rows include Public Land Survey, Property Controlling in Section, and Miscellaneous Property in Sec.

REG. OF DEEDS

Handwritten signature


STATE OF MICHIGAN
COUNTY OF KENT
RECEIVED FOR RECORD
1999 OCT 15 AM 8:07

11370

Register of Deeds Stamp & File Number

4. Lot No. Recorded Plat
5. Private Claims

I, Randy Kolehouse, in a field survey on February 4, 1999, do hereby certify that under requirements of P.A. 74 Michigan P.A. of 1970, the corner points mentioned in lines 1 and 2 above were in conformance with regulations and rules therefore as required in the current manual of survey instructions of the United States Department of the Interior, Bureau of Land Management or by a decree of a Court of Law and/or that the corner points mentioned in lines 3, 4 and 5 above were in conformance with the rules of the Michigan Board of Land Surveyors or by a Decree of a Court of Law; established, re-established, monumented, re-monumented, recovered, found as expressed below:

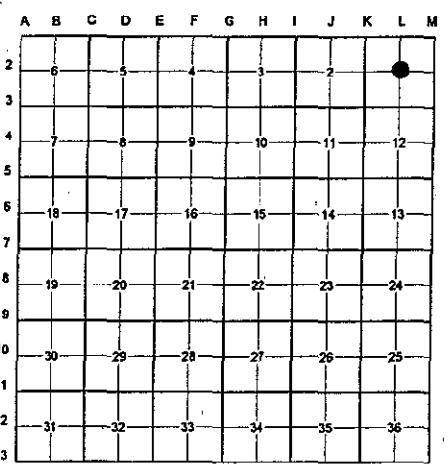

NOTE: Not more than 4 corners, all in the same town and range, may be recorded on this certificate.

A. Description of original monument and accessories and/or subsequent restoration:

- L-2 This corner was not originally set by the G.L.O.
1934 Witness Map K.C. Surveyor 1" Iron Over Stone
1986 L.C.R.C. #4392 Thomas Chettleburgh 1" Iron Over Concrete Monument

P.A. 345 1990 KENT COUNTY
PEER APPROVED 9/25/98
CHAIRMAN Randy Kolehouse


B. Description of corner evidence found and/or method applied in restoring or reestablishing corner:
L-2 Found a 1" iron bar over a concrete monument on the C/L of Benham Street (gravel) running East and West, 4' West of the C/L of Crinnon Avenue (gravel) running North, on line of a tree row running South per L.C.R.C. #4392. This point also checks two witnesses from the 1934 Kent County witness map. The 1" iron is 2.0' East and 1.3' North of the intersection of 1/4 lines. Accepted iron as Center of Section.

- K.C. Witness Map (1934) L.C.R.C. #4392
16" Maple ESE 92.35' (m. 92.60' C/L) Nail in W side tri-12" Oak N14°E 122.70' (m. 122.69')
24" Oak WNW 97.35' (m. 97.87' C/L) Nail in NW side Power Pole N53°E 153.06' (m. 156.02')
Nail in N side 26" Maple S71°E 92.59' (m. 92.60')
Nail in S side 36" Oak N69°W 97.86' (m. 97.87')

The selected location is accepted by me and is generally accepted by professional surveyors as the best available evidence of the position of the original corner.

C. Description of monument for corner and accessories established to perpetuate locating the position of the corner:

- L-2 Replaced 1" Iron and Concrete Monument with a Standard Kent County Monument
Nail & K.C. remon. tag on W side triple 12" Oak N 14° E 122.69'
Nail & K.C. remon. tag on NW side P. pole N 53° E 156.02'
Nail & K.C. remon. tag on N side 26" Maple S 71° E 92.60'
Nail & K.C. remon. tag on S side 42" Oak N 69° W 97.87'
Nail & K.C. remon. tag on W side 12" Oak S 15° W 51.24'
On C/L of gravel road running E-W
C/L of gravel road running N, East 4'
On tree row running S

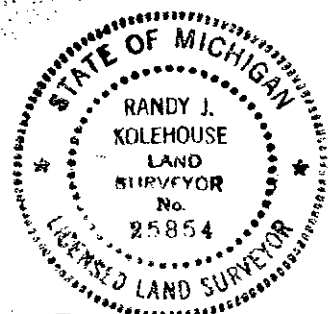

Signed by Randy J. Kolehouse Date 9-27-99

Surveyor's Michigan License No. 25854