

MAY 22 2000

SECTION

LAND CORNER RECORDATION CERTIFICATE
Filing Requirement of Act 74, Mich. P.A. 1970
KENT COUNTY REMONUMENTATION

For corners in

Table with columns: Kent (County), Located in: Courtland Township, Corner Code #. Rows include Public Land Survey, Property Controlling in Section, and Miscellaneous Property in Sec.

REG. OF DEEDS

Handwritten signature/initials

STATE OF MICHIGAN
COUNTY OF KENT
RECEIVED FOR RECORD
1999 OCT 15 AM 8:07

11371

Register of Deeds Stamp & File Number


- 4. Lot No. Recorded Plat
5. Private Claims

I, Randy Kolehouse, in a field survey on February 16 19 99, do hereby certify that under requirements of P.A. 74 Michigan P.A. of 1970, the corner points mentioned in lines 1 and 2 above were in conformance with regulations and rules therefore as required in the current manual of survey instructions of the United States Department of the interior, Bureau of Land Management or by a decree of a Court of Law and/or that the corner points mentioned in lines 3, 4 and 5 above were in conformance with the rules of the Michigan Board of Land Surveyors or by a Decree of a Court of Law; established, re-established, monumented, re-monumented, recovered, found as expressed below:

NOTE: Not more than 4 corners, all in the same town and range, may be recorded on this certificate.

A. Description of original monument and accessories and/or subsequent restoration:

L-3 1837 G.L.O. Notes Cathcart Set Post
1998 L.C.R.C. #11059 T. Sage Set 1/2" Iron and Cap at Midpoint

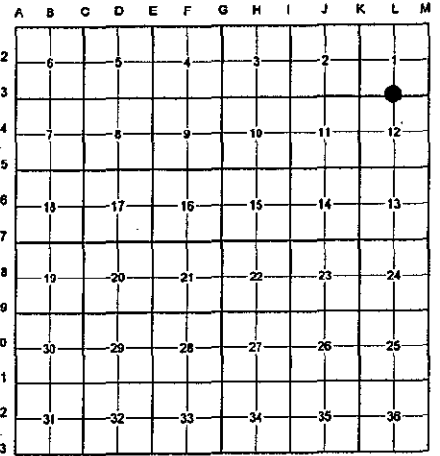

P.A. 345 1990 KENT COUNTY
PEER APPROVED 3/25/99
CHAIRMAN [Signature]

B. Description of corner evidence found and/or method applied in restoring or reestablishing corner:

L-3 Found capped rebar #33139 on line of a tree row running North, 9.0' West of a fence line running North and South, and 30.0' ± North of a tree row running East and West per L.C.R.C. #11059 as set by Thomas Sage at the midpoint and on line between K-3 and M-3. Measure 2546.47' West to K-3. Measure 2546.30' East to M-3. (Per L.C.R.C. #11059 this point faces in the C/L of an old road bed running East and West.)

L.C.R.C. #11059


- Spike & tag, SE. face, 20" Oak, N20E, 13.88' (m. 13.89')
Spike & tag, N. face 10" Twin Maple, S70E, 30.02'
Spike & tag, W. face, 24" Maple, S20W, 33.42'
Spike & tag, N. face, 10" Oak, S80W, 40.55' (m. 40.64')

The selected location is accepted by me and is generally accepted by professional surveyors as the best available evidence of the position of the original corner.

C. Description of monument for corner and accessories established to perpetuate locating the position of the corner:

L-3 Replaced Capped Rebar with a Standard Kent County Monument

- Nail & K.C. remon. tag on W face 18" Oak S 18° W 33.50'
Nail & K.C. remon. tag on N face 10" Oak S 80° W 40.64'
Nail & K.C. remon. tag on SE face 20" Oak N 20° E 13.89'
Nail & K.C. remon. tag on N face double 8" Oak S 80° E 29.97'
On tree row running N
Fence line running N-S, East 9.0'
Tree row running E-W, South 30.0' ±

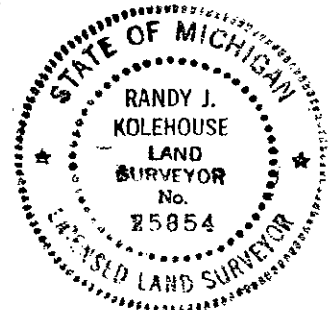

Signed by [Signature] Date 9-27-99

WILLIAMS & WORKS
Surveyor's Michigan License No. 25854