

MAY 22 2000

SECTION

LAND CORNER RECORDATION CERTIFICATE
Filing Requirement of Act 74, Mich. P.A. 1970
KENT COUNTY REMONUMENTATION

For corners in

Kent (County)	Located in: Courtland Township	Corner Code #
1. Public Land Survey	T <u>9N</u> R <u>10W</u>	<u>L-5</u>
	T _____ R _____	_____
	T _____ R _____	_____
	T _____ R _____	_____
2. Property Controlling in Section	S _____ T _____ R _____	_____
	S _____ T _____ R _____	_____
3. Miscellaneous Property in Sec.	S _____ T _____ R _____	_____
	S _____ T _____ R _____	_____

REG. OF DEEDS

[Signature]


STATE OF MICHIGAN
COUNTY OF KENT
RECEIVED FOR RECORD
1999 OCT 15 AM 8:07

11373

Register of Deeds Stamp & File Number

- 4. Lot No. _____, Recorded Plat _____
- 5. Private Claims _____

I, Randy Kolehouse, in a field survey on February 1 19 99, do hereby certify that under requirements of P.A. 74 Michigan P.A. of 1970, the corner points mentioned in lines 1 and 2 above were in conformance with regulations and rules therefore as required in the current manual of survey instructions of the United States Department of the interior, Bureau of Land Management or by a decree of a Court of Law and/or that the corner points mentioned in lines 3, 4 and 5 above were in conformance with the rules of the Michigan Board of Land Surveyors or by a Decree of a Court of Law; established, re-established, monumented, re-monumented, recovered, found as expressed below:

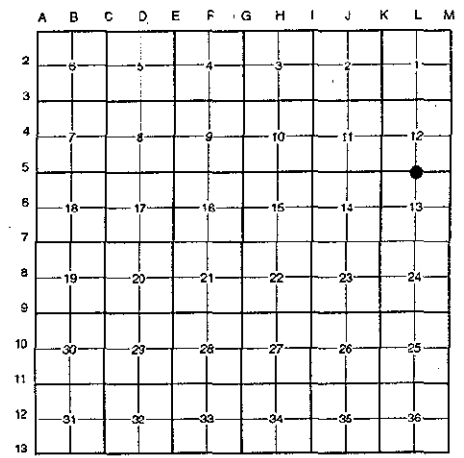

NOTE: Not more than 4 corners, all in the same town and range, may be recorded on this certificate.

- A. Description of original monument and accessories and/or subsequent restoration:
- | | | | | |
|-----|------|----------------|-------------|-------------------------------|
| L-5 | 1837 | G.L.O. Notes | Cathcart | Set Post |
| | 1990 | L.C.R.C. #5305 | K. Roosien | Set PK Nail |
| | 1992 | L.C.R.C. #6623 | John Bueche | Set Point / Set K.C. Monument |

This corner was originally approved by the Kent County Remonumentation Peer Group and monumented by John Bueche in November of 1992 and was recorded per L.C.R.C. #6623.

- B. Description of corner evidence found and/or method applied in restoring or reestablishing corner:
- L-5 Found a Standard Kent County Monument 13.0' ± South of 14 Mile Road (M-57) (bit.) running East and West, on line of a tree row running North, per L.C.R.C. #6623 as set by John Bueche after reestablishing point using witnesses from L.C.R.C. #5305.

- L.C.R.C. #6623
- Nail in W side 22" Oak S 35° E 36.60' (m. 36.64')
 - Nail in N side 16" Maple S 65° E 79.96' (m. 80.02')
 - Nail in NW side 10" Tri. Beech S 35° W 40.48' (m. 40.50')
 - Nail & K.C. Remon. Tag in SE side 8" Beech S 55° W 82.09' (m. 82.15')
 - C/L bit. E-W M-57, N 13' +/-

P.A. 345 1990 KENT COUNTY
PEER APPROVED 2/25/99
CHAIRMAN [Signature]

The selected location is accepted by me and is generally accepted by professional surveyors as the best available evidence of the position of the original corner.

- C. Description of monument for corner and accessories established to perpetuate locating the position of the corner:

- L-5 Standard Kent County Monument
- Nail & K.C. remon. tag on W side 22" Oak S 35° E 36.64'
 - Nail & K.C. remon. tag on N side 16" Maple S 65° E 80.02'
 - Nail & K.C. remon. tag on NW side P. pole N 40° W 56.95'
 - Nail & K.C. remon. tag on E side 8" Elm N 00° E 72.84'
 - Nail & K.C. remon. tag on SE side 8" Beech S 55° W 82.15'
 - Nail & K.C. remon. tag on NW side triple Beech S 35° W 40.50'
 - C/L of bit. road running E-W, North 13.0' ±
 - On tree row running N



Signed by [Signature]
EARTH TECH

Date 3/30/99

Surveyor's Michigan License No. 25854