

MAY 22 2000

1/2

SECTION

LAND CORNER RECORDATION CERTIFICATE  
Filing Requirement of Act 74, Mich. P.A. 1970  
KENT COUNTY REMONUMENTATION

For corners in

Kent (County)	Located in: Courtland Township	Corner Code #
1. Public Land Survey	T <u>9N</u> R <u>10W</u>	<u>L-6</u>
	T _____ R _____	_____
	T _____ R _____	_____
	T _____ R _____	_____
2. Property Controlling in Section	S _____ T _____ R _____	_____
	S _____ T _____ R _____	_____
3. Miscellaneous Property in Sec.	S _____ T _____ R _____	_____
	S _____ T _____ R _____	_____

REG. OF DEEDS

*[Signature]*

STATE OF MICHIGAN  
COUNTY OF KENT  
RECEIVED FOR RECORD  
1999 OCT 15 AM 8:07

11374

Register of Deeds Stamp & File Number


- 4. Lot No. \_\_\_\_\_, Recorded Plat \_\_\_\_\_
- 5. Private Claims \_\_\_\_\_

I, Randy Kolehouse, in a field survey on August 6 19 99, do hereby certify that under requirements of P.A. 74 Michigan P.A. of 1970, the corner points mentioned in lines 1 and 2 above were in conformance with regulations and rules therefore as required in the current manual of survey instructions of the United States Department of the interior, Bureau of Land Management or by a decree of a Court of Law and/or that the corner points mentioned in lines 3, 4 and 5 above were in conformance with the rules of the Michigan Board of Land Surveyors or by a Decree of a Court of Law; established, re-established, monumented, re-monumented, recovered, found as expressed below:

NOTE: Not more than 4 corners, all in the same town and range, may be recorded on this certificate.

A. Description of original monument and accessories and/or subsequent restoration:

L-6 This corner was not originally set by the G.L.O.  
No information on record.

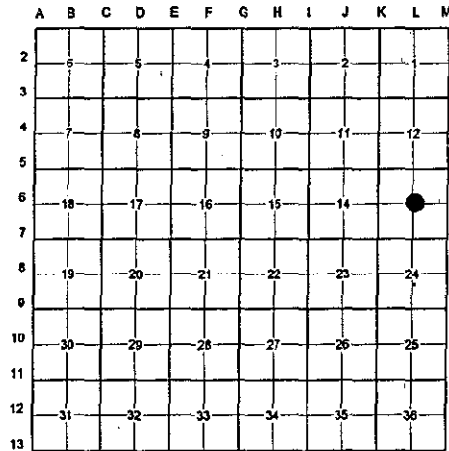

P.A. 345 1990 KENT COUNTY  
PEER APPROVED 8/26/99  
CHAIRMAN *[Signature]*

B. Description of corner evidence found and/or method applied in restoring or reestablishing corner:


L-6 Found nothing at this point. Set corner at the intersection of 1/4 lines. This point falls on the South side of a tree row running East and 45' ± East of a tree row running North and South.

The selected location is accepted by me and is generally accepted by professional surveyors as the best available evidence of the position of the original corner.

C. Description of monument for corner and accessories established to perpetuate locating the position of the corner:

L-6 Set a Standard Kent County Monument

- Nail & K.C. remon. tag on SE face 48" Oak S 30° W 68.15'
- Nail & K.C. remon. tag on S face 6" Butternut S 70° W 38.98
- Nail & K.C. remon. tag on N face 18" Twin Cherry N 83° W 43.00'
- Nail & K.C. remon. tag on SW face 8" Cherry N 30° W 60.81
- Tree row running E, South
- Tree row running N-S, West 45' ±

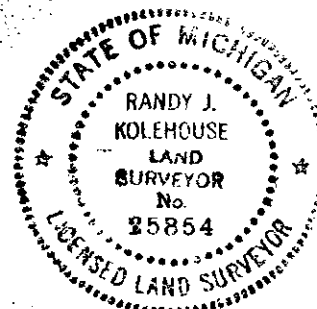

Signed by *[Signature]* Date 9-27-99

WILLIAMS & WORKS

Surveyor's Michigan License No. 25854