

7/2

MAY 22 2000

LAND CORNER RECORDATION CERTIFICATE
Filing Requirement of Act 74, Mich. P.A. 1970
KENT COUNTY REMONUMENTATION

For corners in SECTION

Kent (County)	Located in: Courtland Township	Corner Code #
1. Public Land Survey	T 9N R 10W	L-9
	T R	
	T R	
	T R	
2. Property Controlling in Section	S T R	
	S T R	
3. Miscellaneous Property in Sec.	S T R	
	S T R	

REG. OF DEEDS
[Signature]

STATE OF MICHIGAN
COUNTY OF KENT
RECEIVED FOR RECORD
1999 OCT 15 AM 8:07


11376

Register of Deeds Stamp & File Number

4. Lot No. _____, Recorded Plat _____
5. Private Claims _____

I, Randy Kolehouse, in a field survey on February 4 19 99, do hereby certify that under requirements of P.A. 74 Michigan P.A. of 1970, the corner points mentioned in lines 1 and 2 above were in conformance with regulations and rules therefore as required in the current manual of survey instructions of the United States Department of the interior, Bureau of Land Management or by a decree of a Court of Law and/or that the corner points mentioned in lines 3, 4 and 5 above were in conformance with the rules of the Michigan Board of Land Surveyors or by a Decree of a Court of Law; established, re-established, monumented, re-monumented, recovered, found as expressed below:

NOTE: Not more than 4 corners, all in the same town and range, may be recorded on this certificate.

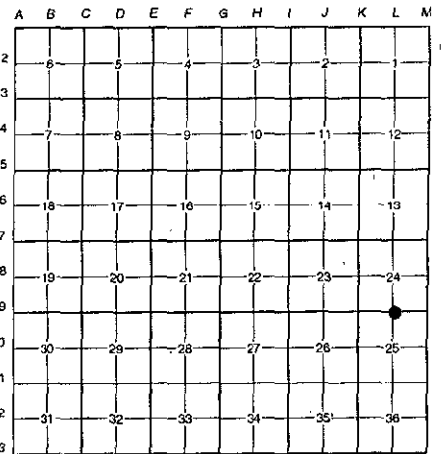

A. Description of original monument and accessories and/or subsequent restoration:

L-9	1837	G.L.O. Notes	Cathcart	Set Post
	1972	Records	Consumers Power Co.	Cement Mon. with Stone / Set "T" Iron
	1984	L.C.R.C. #3781	William Byl	Fnd. Wooden Fence Post / Set K.C. Monument
	1991	L.C.R.C. #6224	C. Marschall	K.C. Monument

This corner was originally approved by the Kent County Remonumentation Peer Group and monumented by William Byl on 12/18/91 and was recorded per L.C.R.C. #3781.

B. Description of corner evidence found and/or method applied in restoring or reestablishing corner:

L-9 Found a broken Standard Kent County Monument on line of a fence line running East and West and 0.5' East of a fence line running North per L.C.R.C.'s #3781 and #6224 as set by William Byl in place of a wooden fence post he found which checked the 1984 records of Consumers Power Company.

L.C.R.C. #3781

Nail & tag, N. sd. 24" Oak S 85 E 91.22'
Nail & tag, W. sd. 12" Maple S 10 W 22.88'
Nail & tag, S. sd. 8" Maple S 60 E 33.47'

L.C.R.C. #6224

Nail & Tag N sd. 26" Oak S 85 E 91.22' (m. 91.11')
Nail & Tag W sd. 24" Maple S 25 W 74.60' (m. 74.5 y+/-)
Nail & Tag W sd. 12" Maple S 10 W 22.88'
Nail & Tag S sd. 16" Maple S 60 E 33.47'
S. Edge of swamp S 0 E 10' more or less

The selected location is accepted by me and is generally accepted by professional surveyors as the best available evidence of the position of the original corner.

C. Description of monument for corner and accessories established to perpetuate locating the position of the corner:


L-9 Reset a Standard Kent County Monument

Nail & K.C. remon. tag on N side 26" Oak S 85° E 91.11'
Nail & K.C. remon. tag on S side 18" Maple S 60° E 33.47'
Nail & K.C. remon. tag on W side 12" Maple S 10 W 22.88'
Nail & K.C. remon. tag on E side 8" Oak N 00° E 8.86'
Nail & K.C. remon. tag on E face 12" wood fence cor. N 90° W 0.39' (at face of tag)
10' +/- N of S edge of swamp
On fence line running E-W
Fence line running N, West 0.5'

P.A. 345 1990 KENT COUNTY

PEER APPROVED 2/25/99

CHAIRMAN *[Signature]*

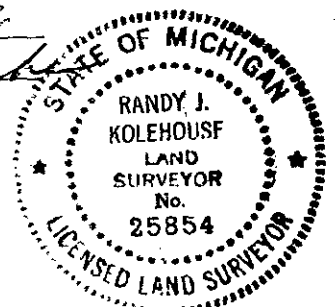

Signed by Randy J. Kolehouse

Date 3/30/99

EARTH TECH

Surveyor's Michigan License No. 25854