

7/2

MAY 22 2000

LAND CORNER RECORDATION CERTIFICATE
Filing Requirement of Act 74, Mich. P.A. 1970
KENT COUNTY REMONUMENTATION

For corners in SECTION Kent (County)

Table with columns: Located in: Courtland Township, Corner Code #. Rows for Public Land Survey, Property Controlling in Section, Miscellaneous Property in Sec.

REG. OF DEEDS

Handwritten signature

1999 OCT 15 AM 8:07
STATE OF MICHIGAN
COUNTY OF KENT
RECEIVED FOR RECORD

11377

Register of Deeds Stamp & File Number

4. Lot No. , Recorded Plat
5. Private Claims

I, Randy Kolehouse, in a field survey on January 12 19 99, do hereby certify that under requirements of P.A. 74 Michigan P.A. of 1970, the corner points mentioned in lines 1 and 2 above were in conformance with regulations and rules therefore as required in the current manual of survey instructions of the United States Department of the interior, Bureau of Land Management or by a decree of a Court of Law and/or that the corner points mentioned in lines 3, 4 and 5 above were in conformance with the rules of the Michigan Board of Land Surveyors or by a Decree of a Court of Law; established, re-established, monumented, re-monumented, recovered, found as expressed below:

NOTE: Not more than 4 corners, all in the same town and range, may be recorded on this certificate.

A. Description of original monument and accessories and/or subsequent restoration:

Table with 4 columns: L-11, 1837, G.L.O. Notes, Cathcart, Set Post, 1962, Witness Map, K.C. Surveyor, Boat Spike, 1974, L.C.R.C. #625, D. South, 1" Pipe in Mon. Box, 1982, L.C.R.C. #3045, Jonker Land Survey, Fnd. 1" Iron in Mon. Box / Set K.C. Mon. in Mon. Box, 1991, L.C.R.C. #6223, C. Marschall, K.C. Monument

This corner was originally approved by the Kent County Remonumentation Peer Group and monumented by C. Marschall on 12/18/91 and was recorded per L.C.R.C. #6223.

B. Description of corner evidence found and/or method applied in restoring or reestablishing corner:

L-11 Found a Standard Kent County Monument on the C/L intersection of 11 Mile Road (bit.) running East and (gravel) running West and Ramsdell Drive (bit.) running South per L.C.R.C.'s #3045 and #6223 as set by Rob Jonker in place of a 1" iron he found in a monument box over a boat spike 18" below grade which checked L.C.R.C. #625 and the K.C. Surveyor's records.

L.C.R.C. #3645

Chisleld "X" on W end conc. culv. S25°W 67.13'
Chisled "X" on E end conc. culv. S20°E 65.30'
SW corner house fnd. N15°W 74.56'
SE corner house fnd. N15°E 75.29'

L.C.R.C. #6223

Nail & Tag in SE sd. P.P. S 45 E 92.12' (m. 92.15')
SW corner Garage Fnd. Conc. N 38 E 90.73' (m. 90.75')
Chiseled "X" on E. end conc. culv. S 20 E 65.29' (m. 65.24')
Chiseled "X" on W. end conc. culv. S 25 W 67.11' (m. 66.97')
On centerline to E-W & S.


The selected location is accepted by me and is generally accepted by professional surveyors as the best available evidence of the position of the original corner.

C. Description of monument for corner and accessories established to perpetuate locating the position of the corner:

L-11 Standard Kent County Monument

Nail & K.C. remon. tag on SE side P. pole S 45° E 92.15'
Chiseled "X" on E end conc. culv. S 20° E 65.24'
Chiseled "X" on W end conc. culv. S 25° W 66.97'
SW cor. fndn. hse. (school) N 15° W 74.61'
SE cor. fndn. hse. (school) N 15° E 75.27'
SW cor. garage fndn. N 38° E 90.75'
On C/L "X" of bit. and gravel roads running E-W-S

P.A. 345 1990 KENT COUNTY
PEER APPROVED 2/25/99
CHAIRMAN

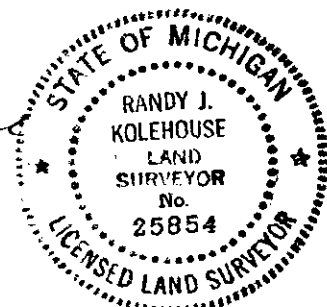

Signed by [Signature] EARTH TECH

Date 3/30/99

Surveyor's Michigan License No. 25854