

**SURVEY & REMONUMENTATION**

\$7.00  
\$2.00 MAR 03 1998

**LAND CORNER RECORDATION CERTIFICATE**  
Filing Requirement of Act 74, Mich. P.A. 1970  
KENT COUNTY REMONUMENTATION


**SECTION**

For corners in

Kent (County)	Located in:	Courtland Township	Corner Code #
1. Public Land Survey	T <u>9N</u>	R <u>10W</u>	<u>L-13</u>
	T _____	R _____	_____
	T _____	R _____	_____
	T _____	R _____	_____
2. Property Controlling in Section	S _____	T _____	R _____
	S _____	T _____	R _____
3. Miscellaneous Property in Sec.	S _____	T _____	R _____
	S _____	T _____	R _____

STATE OF MICHIGAN  
COUNTY OF KENT  
RECEIVED FOR RECORD  
97 NOV 14 AM 9:01  
REG. OF DEEDS  
*Lucy Standa*  
**10329**  
Register of Deeds Stamp & File Number

4. Lot No. \_\_\_\_\_, Recorded Plat \_\_\_\_\_  
5. Private Claims \_\_\_\_\_

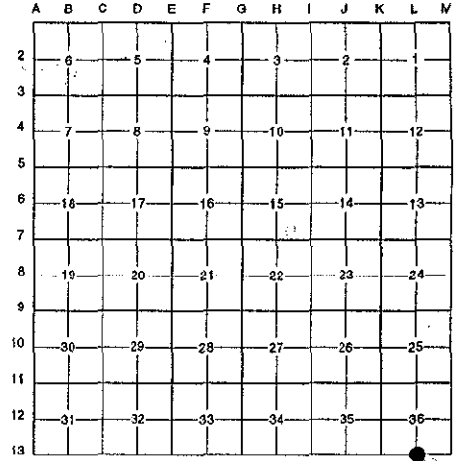

I, Randy Kolehouse, in a field survey on July 14 19 97, do hereby certify that under requirements of P.A. 74 Michigan P.A. of 1970, the corner points mentioned in lines 1 and 2 above were in conformance with regulations and rules therefore as required in the current manual of survey instructions of the United States Department of the interior, Bureau of Land Management or by a decree of a Court of Law and/or that the corner points mentioned in lines 3, 4 and 5 above were in conformance with the rules of the Michigan Board of Land Surveyors or by a Decree of a Court of Law; established, re-established, monumented, re-monumented, recovered, found as expressed below:

**NOTE: Not more than 4 corners, all in the same town and range, may be recorded on this certificate.**

**A. Description of original monument and accessories and/or subsequent restoration:**

L-13	1831	G.L.O. Notes	Mullett	Set Post
	1959	Witness Map	K.C. Surveyor	Monument Box
	1972	L.C.R.C. #204	Exxel Engineering	Boat Spike
	1981	L.C.R.C. #1720	Williams & Works	Fnd. Boat Spike & Iron / Set K.C. Monument
	1991	L.C.R.C. #6222	Chris Marschall	K.C. Monument

Note: This corner is not common with L-1, T8N, R10W.

P.A. 345 1990 KENT COUNTY  
PEER APPROVED 7/24/97  
CHAIRMAN Harry Thubert

This corner was originally approved by the Kent County Remonumentation Peer Group and monumented by Williams & Works on 1/8/81 and was recorded per L.C.R.C. #1720.

**B. Description of corner evidence found and/or method applied in restoring or reestablishing corner:**


L-13 Found a Standard Kent County Monument on the C/L of 10 Mile Road (bit.) running East and West and 20' ± East of the C/L of Ramsdell Drive (bit.) running North and Southwesterly per L.C.R.C.'s #1720 and #6222 as set by Williams & Works in place of a boat spike they found which checked L.C.R.C. #204 and the K.C. Surveyor's records.

L.C.R.C. #1720	L.C.R.C. #6222
K.C. Remon. Tag & Nail in S Side 32" Oak N 80°E 126.42'	K.C. Remon L-1, T8N, R10W East 29.22'
	Nail & Remon tag in W sd. 22" Maple S 41 E 48.03'
	Nail & Remon tag in W sd. 24" Oak S 11 W 68.48'
	Nail & Remon tag in W sd. 36" Oak N 15 E 68.04'
	Nail & Remon tag in S sd. 38" Oak N 79 E 126.33'

The selected location is accepted by me and is generally accepted by professional surveyors as the best available evidence of the position of the original corner.

**C. Description of monument for corner and accessories established to perpetuate locating the position of the corner:**

L-13 Standard Kent County Monument  
Nail & K.C. remon. tag on W side 22" Maple S 41° E 48.03'  
Nail & K.C. remon. tag on W side 24" Oak S 11° W 68.48'  
Nail & K.C. remon. tag on W side 36" Oak N 15° E 68.04'  
Nail & K.C. remon. tag on S side 38' Oak N 79° E 126.33'  
K.C. Mon., L-1, T8N, R10W, East 29.22'

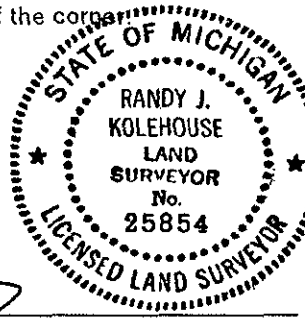

Signed by Randy J. Kolehouse Date 9/23/97  
EARTH TECH

Surveyor's Michigan License No. 25854