

9/2

MAY 22 2009

SECTION

LAND CORNER RECORDATION CERTIFICATE
Filing Requirement of Act 74, Mich. P.A. 1970
KENT COUNTY REMONUMENTATION

For corners in

Table with columns: Kent (County), Located in: Courtland Township, Corner Code #. Rows include Public Land Survey, Property Controlling in Section, and Miscellaneous Property in Sec.


REG. OF DEEDS
STATE OF MICHIGAN
COUNTY OF KENT
RECEIVED FOR RECORD
1999 OCT 15 AM 8:08

11381

Register of Deeds Stamp & File Number

4. Lot No. _____, Recorded Plat _____
5. Private Claims _____

I, Randy Kolehouse, in a field survey on February 4 19 99, do hereby certify that under requirements of P.A. 74 Michigan P.A. of 1970, the corner points mentioned in lines 1 and 2 above were in conformance with regulations and rules therefore as required in the current manual of survey instructions of the United States Department of the interior, Bureau of Land Management or by a decree of a Court of Law and/or that the corner points mentioned in lines 3, 4 and 5 above were in conformance with the rules of the Michigan Board of Land Surveyors or by a Decree of a Court of Law; established, re-established, monumented, re-monumented, recovered, found as expressed below:

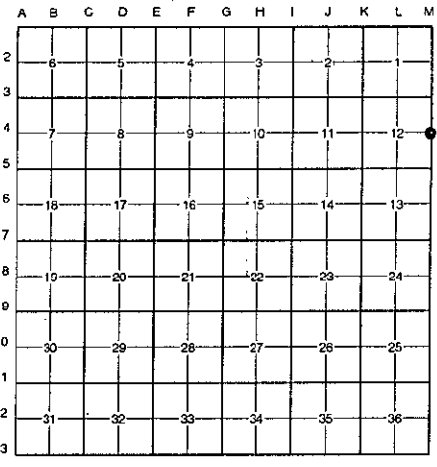

NOTE: Not more than 4 corners, all in the same town and range, may be recorded on this certificate.

A. Description of original monument and accessories and/or subsequent restoration:

Table with columns: M-4, Year, Description, Location, Monument Type. Includes entries for 1837, 1901, 1940, 1963, 1985, and 1992.

Note: This corner is common with A-4, T9N, R9W.

This corner was originally approved by the Kent County Remonumentation Peer Group and monumented by Randy Kolehouse on 8/3/85 and was recorded per L.C.R.C. #4305.

B. Description of corner evidence found and/or method applied in restoring or reestablishing corner:

M-4 Found a Standard Kent County Monument 6.0' West of the C/L of Ramsdell Drive (gravel) running North and South per L.C.R.C.'s #4305 and #6219 as set by Randy Kolehouse in place of a 1" bent iron he found which checked the notes of MSHD and Williams & Works and the K.C. Surveyor's records.

L.C.R.C. #4305

L.C.R.C. #6219

- Nail & K.C. Remon. tag in E. side twin 12" Box Elder N 10° W 81.63'
Nail & K.C. Remon. tag in NE side 8" Maple N 60° W 19.40'
Nail & K.C. Remon. tag in NW side 8" Maple S 60° W 24.22'
Nail & K.C. Remon. tag in E. side 14" Willow S 15° W 41.68'

- Nail & Tag W sd. 16" Willow N 37° E 41.12' (m. 41.19')
Nail & Tag E sd. 20" Willow S 14° W 41.75' (m. 41.76')
Nail & Tag NE sd. 12" Maple N 59° W 19.22' (m. 19.12')
Nail & Tag E sd. Tri. 2-14" & 8" Box Elder N 08° W 81.55' (m. 81.49')
Nail & Tag NW sd. Tri. 10 & 2-6" Maple S 67° W 24.17' (m. 24.12')

The selected location is accepted by me and is generally accepted by professional surveyors as the best available evidence of the position of the original corner.

C. Description of monument for corner and accessories established to perpetuate locating the position of the corner:


- M-4 Standard Kent County Monument
Nail & K.C. remon. tag on W side 20" Willow N 37° E 41.19'
Nail & K.C. remon. tag on E side 22" Willow S 14° W 41.76'
Nail & K.C. remon. tag on NE side 14" Maple N 59° W 19.12'
Nail & K.C. remon. tag on E side triple 2-16" & 10" Box Elder N 08° W 81.49'
Nail & K.C. remon. tag on NW side triple 12" & 2-8" Maple S 67° W 24.12'
C/L of gravel road running N-S, East 6.0'

P.A. 345 1990 KENT COUNTY

PEER APPROVED 2/25/99
CHAIRMAN [Signature]

Signed by Randy J. Kolehouse
EARTH TECH

Date 3/30/99

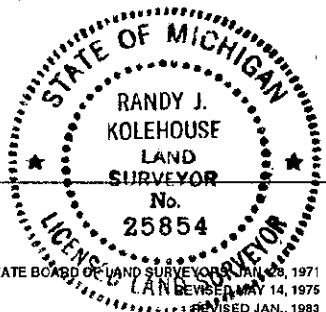

Surveyor's Michigan License No. 25854