

1/2

JAY 22 2000

SECTION

LAND CORNER RECORDATION CERTIFICATE  
Filing Requirement of Act 74, Mich. P.A. 1970  
KENT COUNTY REMONUMENTATION

REG. OF DEEDS

*[Signature]*

STATE OF MICHIGAN  
COUNTY OF KENT  
RECEIVED FOR RECORD  
1999 OCT 15 AM 8:08

For corners in


Kent (County)	Located in: Courtland Township	Corner Code #
1. Public Land Survey	T <u>9N</u> R <u>10W</u>	<u>M-7</u>
	T _____ R _____	_____
	T _____ R _____	_____
	T _____ R _____	_____
2. Property Controlling in Section	S _____ T _____ R _____	_____
	S _____ T _____ R _____	_____
3. Miscellaneous Property in Sec.	S _____ T _____ R _____	_____
	S _____ T _____ R _____	_____
4. Lot No. _____, Recorded Plat _____		
5. Private Claims _____		

11384

Register of Deeds Stamp & File Number

I, Randy Kolehouse, in a field survey on January 18 19 99, do hereby certify that under requirements of P.A. 74 Michigan P.A. of 1970, the corner points mentioned in lines 1 and 2 above were in conformance with regulations and rules therefore as required in the current manual of survey instructions of the United States Department of the interior, Bureau of Land Management or by a decree of a Court of Law and/or that the corner points mentioned in lines 3, 4 and 5 above were in conformance with the rules of the Michigan Board of Land Surveyors or by a Decree of a Court of Law; established, re-established, monumented, re-monumented, recovered, found as expressed below:

**NOTE: Not more than 4 corners, all in the same town and range, may be recorded on this certificate.**

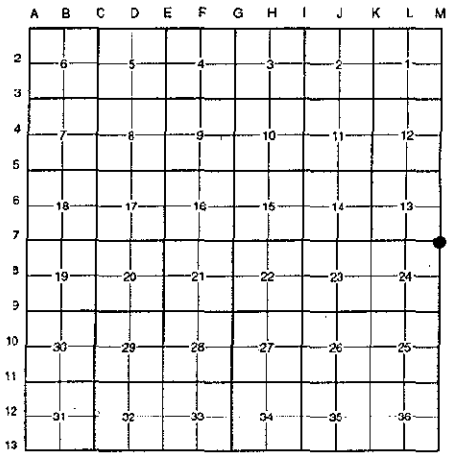

A. Description of original monument and accessories and/or subsequent restoration:

M-7	1837	G.L.O. Notes	Cathcart	Set Post
	1972	Records	Consumers Power Co.	N/A
	1984	L.C.R.C. #3780A	William Byl	Fnd. Spike / Set K.C. Monument
	1991	L.C.R.C. #6216	C. Marschall	K.C. Monument

Note: This corner is common with A-7, T9N, R9W.

This corner was originally approved by the Kent County Remonumentation Peer Group and monumented by William Byl on 3/19/84 and was recorded per L.C.R.C. #3780A.

B. Description of corner evidence found and/or method applied in restoring or reestablishing corner:

M-7 Found a Standard Kent County Monument 1.0' East of the C/L of Ramsdell Drive (bit.) running North and South and 2.0' North of the C/L of 13 Mile Road (gravel) running West per L.C.R.C.'s #3780A and #6216 as set by William Byl in place of a spike he found which checked the 1972 records of Consumers Power.

L.C.R.C. #3780A

L.C.R.C. #6216

- Nail & tag, W. sd. Power pole N 20 W 100.68'
- Nail & tag, S. sd. 24" Oak N 65 W 99.72'
- Nail & tag, S. sd. 24" Oak N 90 E 60.75'
- Nail & tag, E. sd. 18" Pine S 15 E 91.22'

- Nail & Tag S sd. 32" Oak N 65 W 99.63'
- Nail & Tag E sd. 20" Pine S 15 E 91.19' (m. 91.23')
- Nail & Tag S sd. 24" Oak N 90 E 60.73'
- Nail & Tag N sd. 10" Poplar N 42 E 48.87' (m. 48.84')
- Nail & Tag W sd. P.P. N 20 W 100.64'

The selected location is accepted by me and is generally accepted by professional surveyors as the best available evidence of the position of the original corner.

C. Description of monument for corner and accessories established to perpetuate locating the position of the corner:

- M-7 Standard Kent County Monument
- Nail & K.C. remon. tag on S side 32" Oak N 65° W 99.63'
  - Nail & K.C. remon. tag on E side 20" Pine S 15° E 91.23'
  - Nail & K.C. remon. tag on S side 20" Oak N 90° E 60.73'
  - Nail & K.C. remon. tag on N side 10" Poplar N 42° E 48.84'
  - Nail & K.C. remon. tag on W side P. pole N 20° W 100.64'
  - C/L of bit. road running N-S, West 1.0'
  - C/L of gravel road running W, South 2.0'

P.A. 345 1990 KENT COUNTY  
PEER APPROVED 2/25/99  
CHAIRMAN *[Signature]*



Signed by *Randy J. Kolehouse*  
EARTH TECH

Date 3/30/99

Surveyor's Michigan License No. 25854