

MAY 22 2000

LAND CORNER RECORDATION CERTIFICATE
Filing Requirement of Act 74, Mich. P.A. 1970
KENT COUNTY REMONUMENTATION

STATE OF MICHIGAN
COUNTY OF KENT
RECEIVED FOR RECORD
1999 OCT 15 AM 8:08

REG. OF DEEDS

11387

Register of Deeds Stamp & File Number

For corners in

SECTION

Table with columns: Kent (County), Located in: Courtland Township, Corner Code #. Rows include Public Land Survey, Property Controlling in Section, Miscellaneous Property in Sec., Lot No., and Private Claims.

I, Randy Kolehouse, in a field survey on January 12, 1999, do hereby certify that under requirements of P.A. 74 Michigan P.A. of 1970, the corner points mentioned in lines 1 and 2 above were in conformance with regulations and rules...

NOTE: Not more than 4 corners, all in the same town and range, may be recorded on this certificate.

Grid table with columns A-M and rows 1-13. A dot is present in cell M-11.

A. Description of original monument and accessories and/or subsequent restoration:

Table with columns: M-10, 1837, 1862, 1984, 1991, G.L.O. Notes, Cathcart, Consumers Power Co., William R. Byl, Chris Marschall, Set Post, Set 1/2" Rerod and Cap, Fnd. 1/2" Rerod w/ CP Cap / Set K.C. Monument, K.C. Monument.

Note: This corner is common with A-10, T9N, R9W.

This corner was originally approved by the Kent County Remonumentation Peer Group CHAIRMANted by William Byl on 3/19/84 and was recorded per L.C.R.C. #3778.

B. Description of corner evidence found and/or method applied in restoring or reestablishing corner:

M-10 Found a Standard Kent County Monument 1' West of the C/L of Ramsdell Drive (bit.) running North and South, on line of a fence line running West, per L.C.R.C.'s #3778 and #6213 as set by William Byl in place of a 1/2" re-rod and cap he found as set in 1972 by Consumers Power Company

L.C.R.C. #3778A

L.C.R.C. #6213

Nail & tag, S. sd. Power Pole N 90 E 301.30'

Chiseled "X" in top of 12" conc. culv. S. End N 64 W 23.51' (m. 23.50')

Chiseled "X" in top of 12" conc. culv. N. End N 41 W 32.70' (m. 32.73')

Nail & tag S. sd. P.P. N 90 E 301.29' (m. 301.32')


G & A capped iron #9548 West 32.98' (m. 32.94')

The selected location is accepted by me and is generally accepted by professional surveyors as the best available evidence of the position of the original corner.

C. Description of monument for corner and accessories established to perpetuate locating the position of the corner:

M-10 Standard Kent County Monument

- Chiseled "X" top 12" conc. culv. S end N 64° W 23.50'
Chiseled "X" top 12" conc. culv. N end N 41° W 32.73'
Nail & K.C. remon. tag on W side P. pole N 05° W 350.54'
Nail & K.C. remon. tag on S side P. pole N 90° E 301.32'
SE cor. metal bldg. N 18° W 326.19'
G & A capped iron #9548 N 90° W 32.94'
C/L of bit. road running N-S, East 1.0'
On fence line running West

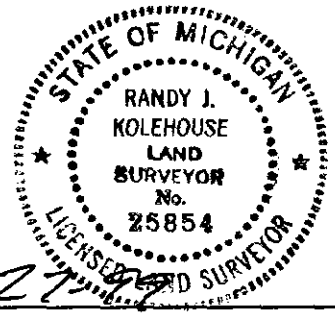

Signed by Randy J. Kolehouse

Date 9-27-99

WILLIAMS & WORKS

Surveyor's Michigan License No. 25854