

STATE & COUNTY REGISTRATION

MAY 22 2000

LAND CORNER RECORDATION CERTIFICATE
Filing Requirement of Act 74, Mich. P.A. 1970
KENT COUNTY REMONUMENTATION

SECTION

For corners in

Table with columns: Kent (County), Located in: Courtland Township, Corner Code #. Rows include Public Land Survey, Property Controlling in Section, Miscellaneous Property in Sec., Lot No., Private Claims.

STATE OF MICHIGAN COUNTY OF KENT RECEIVED FOR RECORD 1999 OCT 15 AM 8:08

REG. OF DEEDS

11388

Register of Deeds Stamp & File Number

I, Randy Kolehouse, in a field survey on March 16, 1999, do hereby certify that under requirements of P.A. 74 Michigan P.A. of 1970, the corner points mentioned in lines 1 and 2 above were in conformance with regulations and rules therefore as required in the current manual of survey instructions of the United States Department of the interior, Bureau of Land Management or by a decree of a Court of Law and/or that the corner points mentioned in lines 3, 4 and 5 above were in conformance with the rules of the Michigan Board of Land Surveyors or by a Decree of a Court of Law; established, re-established, monumented, re-monumented, recovered, found as expressed below:

NOTE: Not more than 4 corners, all in the same town and range, may be recorded on this certificate.

A. Description of original monument and accessories and/or subsequent restoration:

Table with 4 columns: M-11 1837, G.L.O., Notes, Cathcart, Set Post, 1962 Witness Map, K.C. Surveyor, Monument Box / Boat Spike, 1978 L.C.R.C. #1205, Nederveld & Jonker, Round Iron in Monument Box (A-11, T9N, R9W), 1982 L.C.R.C. #3120, Williams & Works, Fnd. 3/4" Iron in Mon. Box / Set K.C. Mon. (A-11, T9N, R9W)

Note: This corner is common with A-11, T9N, R9W.

This corner was originally approved by the Kent County Remonumentation Peer Group and monumented by Williams & Works on 10/18/82 and was recorded per L.C.R.C. #3120.

B. Description of corner evidence found and/or method applied in restoring or reestablishing corner:

M-11 Found a Standard Kent County Monument on the C/L intersection of 11 Mile Road (bit.) running East and West, Ramsdell Drive (bit.) running North and South, on line of a fence line running South, per L.C.R.C.'s #1205 and #3120 as set by Williams & Works in place of a 3/4" iron they found in a monument box which checked the K.C. Surveyor's records.

L.C.R.C. #3120

PK Nail & KC Remon tag in Curb Joint N 30°E 37.75' (m. 37.71') Nail & KC Remon tag in E side 6" Elm N 10°W 134.60' (m. 134.53')

P.A. 345 1990 KENT COUNTY


PEER APPROVED 2/25/99 CHAIRMAN [Signature]

The selected location is accepted by me and is generally accepted by professional surveyors as the best available evidence of the position of the original corner.

C. Description of monument for corner and accessories established to perpetuate locating the position of the corner:

M-11 Standard Kent County Monument

- Nail & K.C. remon. tag on W side 6" Oak S 05° E 111.52'
Nail & K.C. remon. tag on N side 10" Oak S 80° W 233.67'
Nail & K.C. remon. tag on S side 8" dia. fence post N 80° W 139.15'
Nail & K.C. remon. tag on E side 12" Elm N 10° W 134.53'
PK nail top curb joint N 30° E 37.71'
On C/L "X" of bit. roads running N-S & E-W
On fence line running S

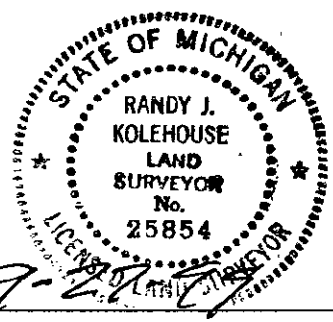

Signed by [Signature] Date

WILLIAMS & WORKS

Surveyor's Michigan License No. 25854