

MAY 22 2000

SECTION

LAND CORNER RECORDATION CERTIFICATE  
Filing Requirement of Act 74, Mich. P.A. 1970  
KENT COUNTY REMONUMENTATION

For corners in

Kent (County)	Located in: Courtland Township	Corner Code #
1. Public Land Survey	T 9N R 10W	M-12
	T _____ R _____	_____
	T _____ R _____	_____
	T _____ R _____	_____
2. Property Controlling in Section	S _____ T _____ R _____	_____
	S _____ T _____ R _____	_____
3. Miscellaneous Property in Sec.	S _____ T _____ R _____	_____
	S _____ T _____ R _____	_____

1999 OCT 15 AM 8:08  
STATE OF MICHIGAN  
COUNTY OF KENT  
RECEIVED FOR RECORD

REG. OF DEEDS

11389  
Register of Deeds Stamp & File Number

4. Lot No. \_\_\_\_\_, Recorded Plat \_\_\_\_\_  
5. Private Claims \_\_\_\_\_

I, Randy Kolehouse, in a field survey on February 3 19 99, do hereby certify that under requirements of P.A. 74 Michigan P.A. of 1970, the corner points mentioned in lines 1 and 2 above were in conformance with regulations and rules therefore as required in the current manual of survey instructions of the United States Department of the interior, Bureau of Land Management or by a decree of a Court of Law and/or that the corner points mentioned in lines 3, 4 and 5 above were in conformance with the rules of the Michigan Board of Land Surveyors or by a Decree of a Court of Law; established, re-established, monumented, re-monumented, recovered, found as expressed below.

NOTE: Not more than 4 corners, all in the same town and range, may be recorded on this certificate.

A. Description of original monument and accessories and/or subsequent restoration:

M-12	1837	G.L.O. Notes	Cathcart	Set Post
	N/A	Witness Map	K.C. Surveyor	Conc. Monument
	1974	L.C.R.C. #623	David L. South	3" Conc. Monument
	1982	L.C.R.C. #3122	Williams & Works	3" Conc. Monument
	1991	L.C.R.C. #6212	Chris Marshall	3" Conc. Monument

Note: This corner is common with A-12, T9N, R9W.

B. Description of corner evidence found and/or method applied in restoring or reestablishing corner:

M-12 Found a 3" diameter concrete monument projecting 3" above a 24" concrete base 80' ± East of the West edge of a swamp, on line of a tree row running West, per L.C.R.C.'s #623, #3122, and #6212.


- L.C.R.C. #3122
- Nail & KC Remon tag in S side 4" Elm N 60°E 5.60'
  - Nail & KC Remon tag in E side 12" Elm S 10°E 25.68'
  - Nail & KC Remon tag in E side 8" Maple N 10°W 69.30'
  - Nail & KC Remon tag in S side 8" Maple N 55°W 43.50'
  - Nail & KC Remon tag in S side 12" Wild Cherry N 75°W 71.82'
  - Steel fence post North 1.50'
  - 1" Iron 4'+/- South and 1.7'+/- East of corner

- L.C.R.C. #6212
- Nail & Tag E sd. 18" Elm S 10 E 25.69' (m. 25.67')
  - Nail & Tag S sd. 14" Elm N 60 E 5.73' (m. 5.72')
  - Nail & tag S sd. 10" Maple Clump N 55 W 43.25' (m. 42.24')
  - Nail & tag N sd. 16" W. Cherry N 90 W 71.61' (m. 71.60')
  - Nail & tag E sd. 10" Maple N 10 W 69.30' (m. 68.49')
  - Steel FNC. Post North 1.50' (m. 1.55')
  - Iron pipe 4' more or less south & 1.7' more or less East of corner
  - Corner is on tree line to west extended east
  - West edge of swamp is 80' more or less west

The selected location is accepted by me and is generally accepted by professional surveyors as the best available evidence of the position of the original corner.

C. Description of monument for corner and accessories established to perpetuate locating the position of the corner:

- M-12 3" Diameter Concrete Monument
- Nail & K.C. remon. tag on E side 18" Elm S 10° E 25.67'
  - Nail & K.C. remon. tag on S side 14" Elm N 60° E 5.72'
  - Nail & K.C. remon. tag on S side 12" Maple clump N 55° W 42.24'
  - Nail & K.C. remon. tag on N side 20" W. Cherry N 90° W 68.49'
  - Iron pipe 14' m/l S & 1.7' m/l E of corner
  - On tree row running W

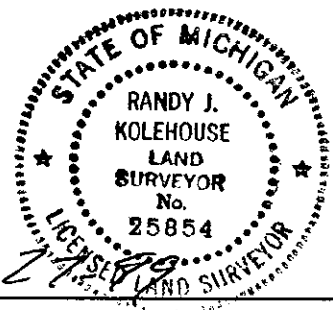

Signed by Randy J. Kolehouse Date 9-2-99  
WILLIAMS & WORKS  
Surveyor's Michigan License No. 25854