

SURVEY & REMONUMENTATION

MAY 22 2000

Seg. 2
Other
code #2

SECTION

LAND CORNER RECORDATION CERTIFICATE
Filing Requirement of Act 74, Mich. P.A. 1970
KENT COUNTY REMONUMENTATION

For corners in

Kent (County)	Located in: Courtland Township	Corner Code #
1. Public Land Survey	T <u>9N</u> R <u>10W</u>	<u>G-10N</u>
	T _____ R _____	_____
	T _____ R _____	_____
	T _____ R _____	_____
2. Property Controlling in Section	S _____ T _____ R _____	<u>1389.84 North</u>
	S _____ T _____ R _____	<u>Of G-10</u>
3. Miscellaneous Property in Sec.	S _____ T _____ R _____	_____
	S _____ T _____ R _____	_____

REG. OF DEEDS

[Signature]

STATE OF MICHIGAN
COUNTY OF KENT
RECEIVED FOR RECORD
1999 OCT 15 AM 8:05

11325

Register of Deeds Stamp & File Number


4. Lot No. _____, Recorded Plat _____
5. Private Claims _____

I, Randy Kolehouse, in a field survey on January 28 19 99, do hereby certify that under requirements of P.A. 74 Michigan P.A. of 1970, the corner points mentioned in lines 1 and 2 above were in conformance with regulations and rules therefore as required in the current manual of survey instructions of the United States Department of the Interior, Bureau of Land Management or by a decree of a Court of Law and/or that the corner points mentioned in lines 3, 4 and 5 above were in conformance with the rules of the Michigan Board of Land Surveyors or by a Decree of a Court of Law; established, re-established, monumented, re-monumented, recovered, found as expressed below:

NOTE: Not more than 4 corners, all in the same town and range, may be recorded on this certificate.

A. Description of original monument and accessories and/or subsequent restoration:

G-10	1837	G.L.O. Notes	Cathcart	Set Post
	N/A	Myers Lakeview Plat L. 65 P. 34	N/A	Concrete Monuments at Plat Corners
	1994	L.C.R.C. #6962	William Byl	Fnd. Concrete Monument / Set K.C. Witness Monument

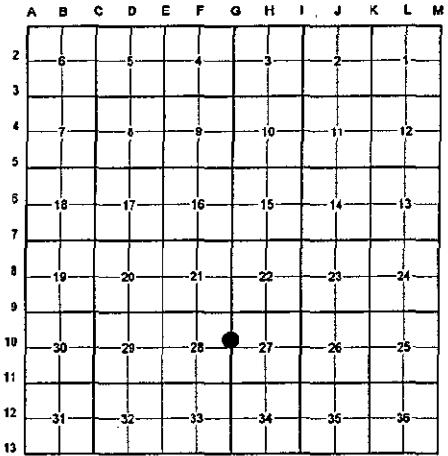

This corner was originally approved by the Kent County Remonumentation Peer Group and monumented by William Byl on 2/18/94 and was recorded per L.C.R.C. #6962.

B. Description of corner evidence found and/or method applied in restoring or reestablishing corner:

G-10 Found a Standard Kent County Witness Monument 32' ± North of the C/L of Hessler Drive (bit.) running East and West and the C/L of Myers Lake Avenue (bit.) extended per L.C.R.C. #6962 as set by William R. Byl in place of a concrete monument he found at plat corners along the East line of Myers Lakeview Plat (Liber 65, Page 34).

L.C.R.C. #6962

- SW cor. conc. porch N55°E 100.08' (m. 100.10')
- Nail & KC Remon. tag SE side Tele. Pole N40°E 40.07' (m. 40.06')
- Nail & KC Remon. tag SW side Tele. Pole N45°W 63.92' (m. 63.89')
- Nail & KC Remon. tag E. side Power Pole S00°E 65.12' (m. 65.15')
- Conc. Monument North 205.30' (m. 205.27')


P.A. 345 1990 KENT COUNTY
PEER APPROVED 2/25/99
CHAIRMAN [Signature]

The selected location is accepted by me and is generally accepted by professional surveyors as the best available evidence of the position of the original corner.

C. Description of monument for corner and accessories established to perpetuate locating the position of the corner:

G-10 Standard Kent County Witness Monument

- Nail & K.C. remon. tag on SE side Tele. pole N 40° E 40.06'
- Nail & K.C. remon. tag on SW side Tele. pole N 45° W 63.89'
- Nail & K.C. remon. tag on E side P. pole S 00° E 65.15'
- SW cor. conc. porch N 55° E 100.10'
- Conc. mon. North 205.27'
- C/L of bit. road running E-W, South 32'

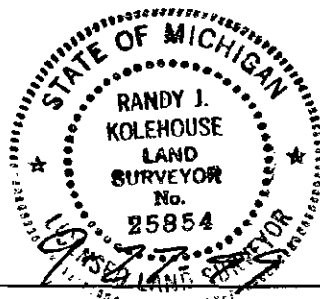

Signed by [Signature]
WILLIAMS & WORKS

Date _____

Surveyor's Michigan License No. 25854