

MAY 22 2000

SECTION

LAND CORNER RECORDATION CERTIFICATE
Filing Requirement of Act 74, Mich. P.A. 1970
KENT COUNTY REMONUMENTATION

For corners in

Table with columns: Kent (County), Located in: Courtland Township, Corner Code #. Rows include Public Land Survey, Property Controlling in Section, and Miscellaneous Property in Sec.

Handwritten note: "Seg. 2" "Other" code #4

REG. OF DEEDS

Handwritten signature

STATE OF MICHIGAN COUNTY OF KENT RECEIVED FOR RECORD 1999 OCT 15 AM 8:05

11327


Register of Deeds Stamp & File Number

- 4. Lot No.
5. Private Claims

I, Randy Kolehouse, in a field survey on January 28 19 99, do hereby certify that under requirements of P.A. 74 Michigan P.A. of 1970, the corner points mentioned in lines 1 and 2 above were in conformance with regulations and rules therefore as required in the current manual of survey instructions of the United States Department of the interior, Bureau of Land Management or by a decree of a Court of Law and/or that the corner points mentioned in lines 3, 4 and 5 above were in conformance with the rules of the Michigan Board of Land Surveyors or by a Decree of a Court of Law; established, re-established, monumented, re-monumented, recovered, found as expressed below:

NOTE: Not more than 4 corners, all in the same town and range, may be recorded on this certificate.

Table with columns: Description of original monument and accessories and/or subsequent restoration: G-10 1837, G.L.O. Notes, Cathcart, Set Post, 1919-1976, Survey Notes, Williams & Works, Iron, 1994, L.C.R.C. #6965, William R. Byl, Fnd. Iron / Set K.C. Witness Monument

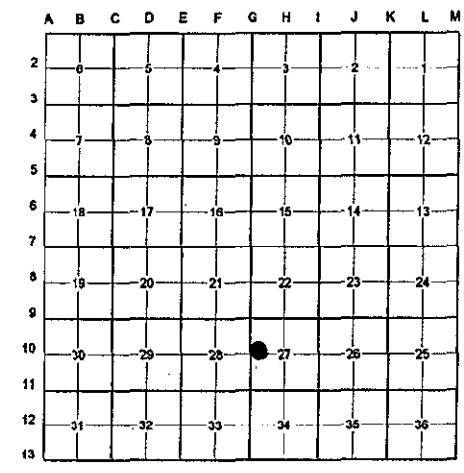

This corner was originally approved by the Kent County Remonumentation Peer Group and monumented by William R. Byl on 2/18/99 and was recorded per L.C.R.C. #6965.

Description of corner evidence found and/or method applied in restoring or reestablishing corner: Found a Standard Kent County Witness Monument 12' +/- West of the C/L of Hessler Drive (bit.) running North and South per L.C.R.C. #6965 as set by William Byl in place of a iron used in various surveys by Williams & Works.

L.C.R.C. #6965


- NE cor. fdn. Hse. #7502 S40°W 67.70' (m. 67.73')
Nail & KC Remon. tag S. side 30" Oak S80°W 27.51' (m. 27.53')
Nail & KC Remon. tag E. side 36" Oak N10°W 16.22' (m. 16.13')
Nail & KC Remon. tag S. side 30" Oak S75°E 43.59' (m. 43.64')
Nail & KC Remon. tag E. side Power Pole S45°E 55.40' (m. 55.47')

P.A. 345 1990 KENT COUNTY PEER APPROVED 2/25/99 CHAIRMAN [Signature]

The selected location is accepted by me and is generally accepted by professional surveyors as the best available evidence of the position of the original corner.

Description of monument for corner and accessories established to perpetuate locating the position of the corner: Standard Kent County Witness Monument

- NE cor. conc. fndn. hse. #7502 S 40° W 67.73'
Nail & K.C. remon. tag on S side 30" Oak S 80° W 27.53'
Nail & K.C. remon. tag on E side 36" Oak N 10° W 16.13'
Nail & K.C. remon. tag on S side 30" Oak S 75° E 43.64'
Nail & K.C. remon. tag on E side P. pole S 45° E 55.47'
C/L of bit. road running N-S, East 12'

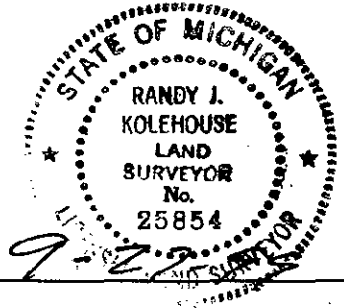

Signed by [Signature] Date 9-27-99
WILLIAMS & WORKS
Surveyor's Michigan License No. 25854