

**SURVEY & REMONUMENTATION**

**KENT COUNTY REMONUMENTATION**

STATE OF MICHIGAN  
COUNTY OF KENT  
RECEIVED FOR RECORD

**LAND CORNER RECORDATION CERTIFICATE**  
Filing Requirement of Act 74, Mich. P.A. 1970

98 JUL 14 AM 9:54

For corners in **SECTION**

| KENT COUNTY<br>(County)            | Located In:                            | Corner Code # |
|------------------------------------|--|---------------|
| 1. Public Land Survey              | T <u>9N</u> R <u>11W</u>               | <u>B-3</u>    |
|                                    | T <u>   </u> R <u>   </u>              | <u>   </u>    |
|                                    | T <u>   </u> R <u>   </u>              | <u>   </u>    |
|                                    | T <u>   </u> R <u>   </u>              | <u>   </u>    |
| 2. Property Controlling in Section | S <u>   </u> T <u>   </u> R <u>   </u> | <u>   </u>    |
|                                    | S <u>   </u> T <u>   </u> R <u>   </u> | <u>   </u>    |
| 3. Miscellaneous Property in Sec.  | S <u>   </u> T <u>   </u> R <u>   </u> | <u>   </u>    |
|                                    | S <u>   </u> T <u>   </u> R <u>   </u> | <u>   </u>    |


*W. J. Bond*  
REG. OF DEEDS

**10642**

Register of Deeds Stamp & File Number

4. Lot No. \_\_\_\_\_, Recorded Plat \_\_\_\_\_  
5. Private Claims \_\_\_\_\_

I, Kirk Breitels, in a field survey on May 1, 19 98 do hereby state that under requirements of P.A. 74, Michigan P.A. of 1970, the corner points mentioned in lines 1 and 2 above were in conformance with regulations and rules therefore as required in the current manual of survey instructions of the United States Department of the Interior, Bureau of Land Management or by a decree of a Court of Law and /or that the corner points mentioned in lines 3, 4 and 5 above were in conformance with the rules of the Michigan Board of Land Surveyors or by a Decree of a Court of Law; established, re-established, monumented, recovered, found as expressed below:

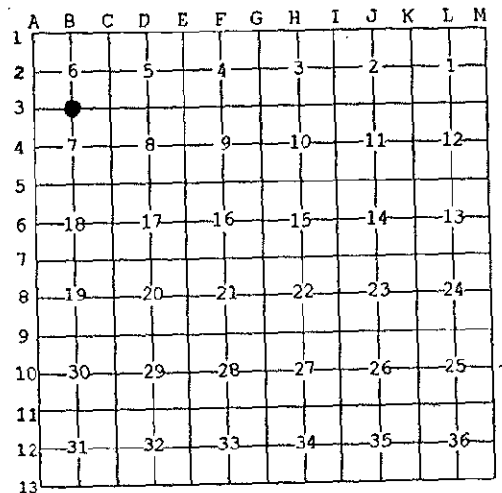

NOTE: Not more than 2 corners, all in the same town and range, may be recorded on this certificate.

**A. Description of original monument and accessories and/or subsequent restoration:**

|     |      |               |           |                          |
|-----|------|---------------|-----------|--------------------------|
| B-3 | 1837 | GLO           | Whitcomb  | Set Post                 |
|     | 1956 | Kent Co. Wits |           | Iron                     |
|     | 1983 | LCRC #3406    | Glaza     | 1" Iron Pipe             |
|     | 1984 | LCRC #3790    | Byl       | Set Kent County Monument |
|     | 1990 | LCRC #5633    | Marschall | Kent County Monument     |

P.A. 345 1990 KENT COUNTY

PEER APPROVED 6/25/98

CHAIRMAN *[Signature]*

The position of this corner was previously approved by the Kent County Remonumentation Peer Group, monumented by William R. Byl on 3-28-84 and was recorded per LCRC #3790.

**B. Description of corner evidence found and/or method applied in restoring or reestablishing corner:**

B-3 Found Kent County Monument (Harrison) per witnesses from above LCRC as set by William R. Byl in place of the 1" Iron Pipe he found next to stones. All witnesses from Kent Co. Wits. and LCRC #3790 are gone.

| LCRC #3790                         | LCRC #5633    |                                    |               |
|------------------------------------|---------------|------------------------------------|---------------|
| Nail & Remon. tag 12" Pine         | N55°W 50.34'  | Nail & Remon. tag 12" Pine         | N55°W 50.35'  |
| Nail & Remon. tag 12" Pine         | S35°E 42.95'  | Nail & Remon. tag 12" Pine         | S35°W 42.94'  |
| Nail & Remon. tag 36" Cherry       | N90°E 206.40' | Nail & Remon. tag 36" Cherry       | N90°E 206.40' |
| NW cor. conc. hse. fnd. (wingwall) | S30°E 213.15' | NW cor. conc. hse. fnd. (wingwall) | S30°E 213.15' |
|                                    |               | 4" x 4" wood fence post (face)     | N45°E 0.3'    |

The selected location is accepted by me and is generally accepted by professional surveyors as the best available evidence of the position of the original corner.

**C. Description of monument for corner and accessories established to perpetuate locating the position of the corner:**

|   |               |
|---|---------------|
| B-3 Standard Kent County Monument           |               |
| Nail & KC Remon. tag N. side 14" Pine       | N55°W 50.35'  |
| Nail & KC Remon. tag N. side 12" Pine       | S80°W 21.86'  |
| Nail & KC Remon. tag E. side 12" Pine       | S35°W 42.94'  |
| Nail & KC Remon. tag N. side 38" Cherry     | N90°E 206.40' |
| NW corner conc. hse. fnd. (top 6' wingwall) | S30°E 213.15' |
| Face of 4" x 4" wood fence post             | N45°E 0.3'    |



Signed by *Kirk Breitels*  
Surveyor's Michigan License No. 30077

Date 6/25/98