SURVEY & REMONUMENTATION

MAR 0 8 1999

SECTION

KENT COUNTY REMONUMENTATION

LAND CORNER RECORDATION CERTIFICATE
Filing Requirement of Act 74, Mich. P.A. 1970

STATE OF MICHIGAN
COUNTY OF KENT
RECEIVED FOR RECORD
98 OCT -7 AM 10: 15
REG. OF DEEDS

10679
Register of Deeds Stamp & File Number

For corners in
KENT COUNTY
(County)

	Located in:	Corner Code #
1. Public Land Survey	T9N R11W	B-8
	T___ R___	
	T___ R___	
	T___ R___	
2. Property Controlling	S___ T___ R___	
in Section	S___ T___ R___	
3. Miscellaneous	S___ T___ R___	
Property in Sec.	S___ T___ R___	

4. Lot No. _____, Recorded Plat _____
5. Private Claims _____

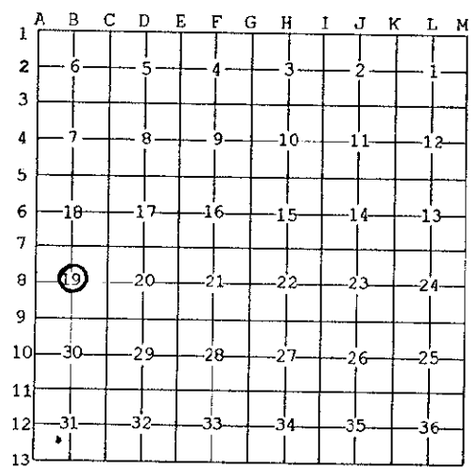

I, Kirk Breitels, in a field survey on July 28, 19 98 do hereby state that under requirements of P.A. 74, Michigan P.A. of 1970, the corner points mentioned in lines 1 and 2 above were in conformance with regulations and rules therefore as required in the current manual of survey instructions of the United States Department of the Interior, Bureau of Land Management or by a decree of a Court of Law and /or that the corner points mentioned in lines 3, 4 and 5 above were in conformance with the rules of the Michigan Board of Land Surveyors or by a Decree of a Court of Law; established, re-established, monumented, recovered, found as expressed below:

NOTE: Not more than 2 corners, all in the same town and range, may be recorded on this certificate.

A. Description of original monument and accessories and/or subsequent restoration:

B-8	1837	GLO	Not Set
		Williams & Works	No information
		Kent Co. Wits	No information

P.A. 345 1990 KENT COUNTY
PEER APPROVED 8/20/98
CHAIRMAN Stanley Huber

B. Description of corner evidence found and/or method applied in restoring or reestablishing corner:

B-8 Established Intersection of 1/4 lines and found remains of fence to West being 8' South and remains of fence to North being 9' West. Also found Capped Rerod (Glaza) to be 12.56' North and 0.2' West of the Intersection of 1/4 lines. Glaza Capped Rerod is at "Center" of Section and SE corner of a parcel he surveyed in 1975. Disgarded this Capped Rerod as the "Center" because its location did not fit Glaza measurements of the survey by 6'.

The Intersection of 1/4 lines fits computed information of surveys by Hackbardt and Roosien.

The Intersection of 1/4 lines is accepted by me and is generally accepted by professional surveyors as the best available evidence of the position of the corner.

C. Description of monument for corner and accessories established to perpetuate locating the position of the corner:

B-8 Set Standard Kent County Monument at the Intersection of 1/4 lines.

Nail & KC Remon. tag N. side 12" Pine	N70°E	91.59'
Nail & KC Remon. tag E. side 10" Walnut	N10°E	47.92'
Nail & KC Remon. tag NE side 12" Oak	N45°W	53.05'
Nail & KC Remon. tag N. side 36" Oak	S85°W	65.29'
Capped Rerod (Glaza)	North	12.56'
Fence to West is 8' South		
Fence to North is 9' West		

STATE OF MICHIGAN
KIRK BREITELS
LAND SURVEYOR
NO
30077
LICENSED LAND SURVEYOR

Signed by Kirk Breitels
Surveyor's Michigan License No. 30077

Date 9/25/98

FORM APPROVED BY MICHIGAN STATE BOARD OF PROFESSIONAL SURVEYORS, JAN. 28, 1971
REVISED MAY 14, 1975
REVISED JAN., 1983
REVISED OCT., 1995