

\$7.00
\$2.00

SURVEY & REMONUMENTATION

KENT COUNTY REMONUMENTATION

STATE OF MICHIGAN
COUNTY OF KENT
RECEIVED FOR RECORD

MAR 08 1999

LAND CORNER RECORDATION CERTIFICATE
Filing Requirement of Act 74, Mich. P.A. 1970

98 JUL 14 AM 9:54

For corners in SECTION
KENT COUNTY Located in: Corner Code #
(County)

1. Public Land Survey T 9N R 11W C-3
T _____ R _____
T _____ R _____
T _____ R _____

2. Property Controlling in Section S _____ T _____ R _____
S _____ T _____ R _____

3. Miscellaneous Property in Sec. S _____ T _____ R _____
S _____ T _____ R _____


W. J. Bond
REG. OF DEEDS

10645

Register of Deeds Stamp & File Number

4. Lot No. _____, Recorded Plat _____
5. Private Claims _____

I, Kirk Breitels, in a field survey on May 1, 1998 do hereby state that under requirements of P.A. 74, Michigan P.A. of 1970, the corner points mentioned in lines 1 and 2 above were in conformance with regulations and rules therefore as required in the current manual of survey instructions of the United States Department of the Interior, Bureau of Land Management or by a decree of a Court of Law and/or that the corner points mentioned in lines 3, 4 and 5 above were in conformance with the rules of the Michigan Board of Land Surveyors or by a Decree of a Court of Law; established, re-established, monumented, recovered, found as expressed below:

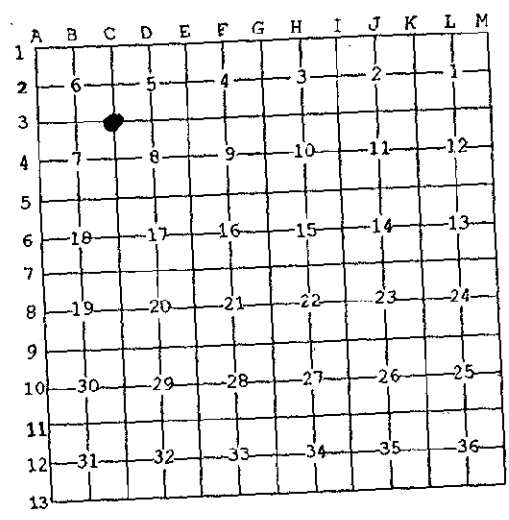

NOTE: Not more than 2 corners, all in the same town and range, may be recorded on this certificate.

A. Description of original monument and accessories and/or subsequent restoration:

C-3	1837	GLO	Whitcomb	Set Post
	1930	Kent Co. Wits		Stone
	1981	LCRC #1627	Byl	Iron Pipe & Stone
	1982	LCRC #2910	Jonker	Set Kent County Monument
	1990	LCRC #5641	Marschall	Kent County Monument

P.A. 345 1990 KENT COUNTY
PEER APPROVED 6/25/98
CHAIRMAN *Harry Huber*

The position of this corner was previously approved by the Kent County Remonumentation Peer Group, monumented by Robert J. Jonker on 6-3-82 and was recorded per LCRC #2910.

B. Description of corner evidence found and/or method applied in restoring or reestablishing corner:

C-3 Found Kent County Monument (Harrison) per witnesses from above LCRC as set by Robert j. Jonker in place of the 3/4" Iron over a 1 1/4" Iron he found in a pile of stones. All check with Kent Co. Wits. and LCRC #1627.
LCRC #2910
Nail & Remon. tag 8" Oak S75°W 18.46'
Nail & Remon. tag 36" Pine N70°W 49.93'
Nail & Remon. tag 18" Oak N40°E 46.36'
Nail & Remon. tag 2" Oak S10°W 8.24'
C.P. Iron East 66.0'
C.P. Iron South 65.85'(top) - 66.2' (base)

LCRC #5641
Nail & Remon. tag 22" Oak N40°E 46.30'
Nail & Remon. tag 40" Pine N70°W 49.92'
Nail & Remon. tag 12" Oak S75°W 18.46'
C.P. Iron East 66.00'
C.P. Iron South 65.58' (top) - 66.2' (base)

The selected location is accepted by me and is generally accepted by professional surveyors as the best available evidence of the position of the original corner.

C. Description of monument for corner and accessories established to perpetuate locating the position of the corner:

C-3 Standard Kent County Monument

Nail & KC Remon. tag SE side 26" Oak	N40°E 46.15'
Nail & KC Remon. tag N. side 42" Pine	N70°W 49.85'
Nail & KC Remon. tag N. side 15" Oak	S75°W 18.46'
C.P. Iron	East 66.00'
C.P. Iron	South 65.85' (top) 66.2' (base)

4" x 4" wood fence corner post North 0.15'



Signed by *Kirk Breitels*
Surveyor's Michigan License No. 30077

Date 6/25/98