

SURVEY & REMONUMENTATION

\$7.00
\$2.00

MAR 08 1998

KENT COUNTY REMONUMENTATION

LAND CORNER RECORDATION CERTIFICATE
Filing Requirement of Act 74, Mich. P.A. 1970

STATE OF MICHIGAN
COUNTY OF KENT
RECEIVED FOR RECORD
98 MAR -5 AM 8:32
REG. OF DEEDS
Eric S. Bond

For corners in
KENT COUNTY
(County)

Located In:	Corner Code #
T 9N R 11W	C-5
T R	
T R	
T R	
T R	
S T R	
S T R	
S T R	
S T R	

- Public Land Survey
- Property Controlling in Section
- Miscellaneous Property in Sec.


10513

Register of Deeds Stamp & File Number

- Lot No. _____, Recorded Plat _____
- Private Claims _____

I, Kirk Breitels, in a field survey on Jan. 2, 1998 do hereby state that under requirements of P.A. 74, Michigan P.A. of 1970, the corner points mentioned in lines 1 and 2 above were in conformance with regulations and rules therefore as required in the current manual of survey instructions of the United States Department of the Interior, Bureau of Land Management or by a decree of a Court of Law and /or that the corner points mentioned in lines 3, 4 and 5 above were in conformance with the rules of the Michigan Board of Land Surveyors or by a Decree of a Court of Law, established, re-established, monumented, recovered, found as expressed below:

NOTE: Not more than 2 corners, all in the same town and range, may be recorded on this certificate.

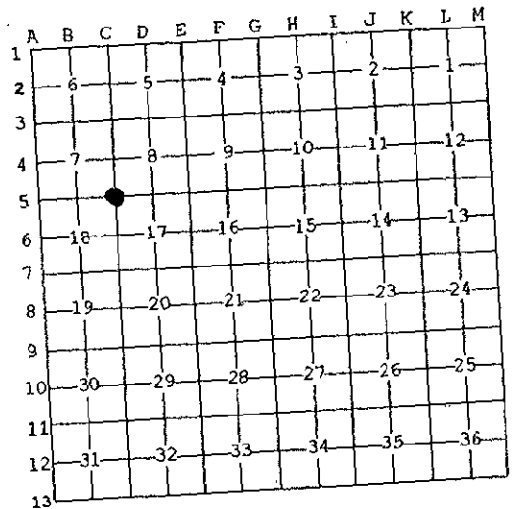

A. Description of original monument and accessories and/or subsequent restoration:

C-5	1837	GLO	Whitcomb	Set Post
	1956	Kent Co. Wits		1" Iron
	1974	LCRC #728	Nederveld	Boat Spike
	1981	LCRC#2454	Jonker	Set Kent County Monument
	1990	LCRC #5643	Marschall	Kent Co. Mon.

P.A. 345 1990 KENT COUNTY
PEER APPROVED 2/19/98
CHAIRMAN *Harry Kuehner*

The position of this corner was previously approved by the Kent County Remonumentation Peer Group, monumented by Robert J. Jonker on 11-20-81 and was recorded per LCRC #2454.

B. Description of corner evidence found and/or method applied in restoring or reestablishing corner:

- C-5 Found Kent County Monument (Harrison) per witnesses from above LCRC as set by Robert J. Jonker in place of the Boat Spike over "T" Iron he found. Both Irons checks with LCRC #728.
- | LCRC #2454 | LCRC #5643 | |
|-----------------------------------|--------------|--|
| Nail & Remon. tag 24" Maple | N75°E 59.25' | Nail & Remon. tag P.P. N36°E 48.57' |
| Nail & Remon. tag T. Pole | S80°W 37.68' | Nail & Remon. tag T.P. S73°W 37.63' |
| Nail & Remon. tag Cor. Fence Post | N30°W 50.57' | Nail & Remon. tag Fence cor. Post N35°W 51.03' |
| C/L street sign | S60°E 50.3' | Nail & Remon. tag Guy Pole S24°E 71.75' |
| C/L "X" of pvt. Is 5' E ± | | Nail & Remon. tag 26" Maple stump N62°E 58.62' |
| | | C/L "X" of pavement is East 5' ± |

The selected location is accepted by me and is generally accepted by professional surveyors as the best available evidence of the position of the original corner.

C. Description of monument for corner and accessories established to perpetuate locating the position of the corner:

C-5 Standard Kent County Monument	
Nail & KC Remon. tag W. side P. Pole	N36°E 48.61'
Nail & KC Remon. tag S. side T. Pole	S73°W 37.63'
Nail & KC Remon. tag E. side fence cor. post	N35°W 51.73'
Nail & KC Remon. tag W. side Guy Pole	S24°E 71.77'
Nail & KC Remon. tag S. side 26" Maple stump	N62°E 59.25'
C/L "X" pavement is 5' ± East	



Signed by *Kirk Breitels*
Surveyor's Michigan License No. 30077

Date 2/19/98