

SURVEY & REMONUMENTATION

KENT COUNTY REMONUMENTATION

STATE OF MICHIGAN
COUNTY OF KENT
RECEIVED FOR RECORD

\$7.00
\$2.00

MAR 08 1999

LAND CORNER RECORDATION CERTIFICATE
Filing Requirement of Act 74, Mich. P.A. 1970

98 JUL 14 AM 9:54

For corners in SECTION
KENT COUNTY

Located In: Corner Code #

(County)	Located In:	Corner Code #
1. Public Land Survey	T ^{9N} R ^{11W}	C-7
	T R	
	T R	
	T R	
2. Property Controlling in Section	S T R	
	S T R	
3. Miscellaneous Property in Sec.	S T R	
	S T R	

Leif J. Bond
REG. OF DEEDS


10646

Register of Deeds Stamp & File Number

4. Lot No. _____, Recorded Plat _____
5. Private Claims _____

I, Kirk Breitels, in a field survey on June 22, 1998 do hereby state that under requirements of P.A. 74, Michigan P.A. of 1970, the corner points mentioned in lines 1 and 2 above were in conformance with regulations and rules therefore as required in the current manual of survey instructions of the United States Department of the Interior, Bureau of Land Management or by a decree of a Court of Law and /or that the corner points mentioned in lines 3, 4 and 5 above were in conformance with the rules of the Michigan Board of Land Surveyors or by a Decree of a Court of Law; established, re-established, monumented, recovered, found as expressed below:

NOTE: Not more than 2 corners, all in the same town and range, may be recorded on this certificate.

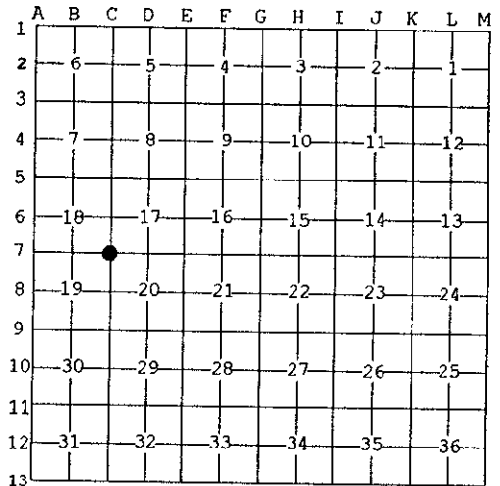

A. Description of original monument and accessories and/or subsequent restoration:

C-7	1837	GLO	Whitcomb	Set Post
	1973	LCRC #456	VanKooten	Iron in Mon. Box
	1981	LCRC #2456	Jonker	Set Kent County Monument
	1990	LCRC #5645	Marschall	Kent County Monument

P.A. 345 1990 KENT COUNTY

PEER APPROVED 6/25/98
CHAIRMAN [Signature]

The position of this corner was previously approved by the Kent County Remonumentation Peer Group, monumented by Robert J. Jonker on 11-20-81 and was recorded per LCRC #2456.

B. Description of corner evidence found and/or method applied in restoring or reestablishing corner:

C-7 Found Kent County Monument (Harrison) per witnesses from above LCRC as set by Robert J. Jonker in place of the 3/4" Iron he found inside a Mon. Box. Said Iron checks with LCRC #456.

LCRC #2456	LCRC #5645
Nail & Remon. tag fence post S02°W 43.53'	Nail & Remon. tag top of guard post N41°E 28.31'
Nail & Remon. tag guard post N14°W 21.45'	Nail & Remon. tag top of guard post N43°W 27.99'
Nail & Remon. tag guard post N62°W 48.30'	Nail & Remon. tag P. Pole S65°W 140.93'
Nail & Remon. tag guard post N44°E 28.24'	Nail & Remon. tag bent RR tie fc. post South 43.51'
C/L pavement is 3' South	C/L pavement is South 3' ±

The selected location is accepted by me and is generally accepted by professional surveyors as the best available evidence of the position of the original corner.

C. Description of monument for corner and accessories established to perpetuate locating the position of the corner:

C-7 Standard Kent County Monument	
Nail & KC Remon. tag in top of guard rail post	N41°E 28.42'
Nail & KC Remon. tag in top of guard rail post	N43°W 28.03'
Nail & KC Remon. tag SE side P. Pole	S65°W 140.93'
Nail & KC Remon. tag W. side bent RR tie fence post	South 43.53'
Nail & KC Remon. tag SE corner wood sign post	N70°E 63.52'



Signed by [Signature]
Surveyor's Michigan License No. 30077

Date 6/25/98