

SURVEY & REMONUMENTATION

MAR 08 1999

KENT COUNTY REMONUMENTATION

LAND CORNER RECORDATION CERTIFICATE
Filing Requirement of Act 74, Mich. P.A. 1970

\$7.00
\$2.00

SECTION

For corners in

KENT COUNTY
(County)

Located In:

Corner Code #

- | | | | |
|------------------------------------|--------------|---------------|------------|
| 1. Public Land Survey | T <u>9</u> N | R <u>11</u> W | <u>D-5</u> |
| | T | R | |
| | T | R | |
| | T | R | |
| 2. Property Controlling in Section | S | T | R |
| | S | T | R |
| 3. Miscellaneous Property in Sec. | S | T | R |
| | S | T | R |

4. Lot No. _____, Recorded Plat _____
5. Private Claims _____

I, Kirk Breitels, in a field survey on Jan. 2, 1998 do hereby state that under requirements of P.A. 74, Michigan P.A. of 1970, the corner points mentioned in lines 1 and 2 above were in conformance with regulations and rules therefore as required in the current manual of survey instructions of the United States Department of the Interior, Bureau of Land Management or by a decree of a Court of Law and for that the corner points mentioned in lines 3, 4 and 5 above were in conformance with the rules of the Michigan Board of Land Surveyors or by a Decree of a Court of Law; established, re-established, monumented, recovered, found as expressed below:

NOTE: Not more than 2 corners, all in the same town and range, may be recorded on this certificate.

A. Description of original monument and accessories and/or subsequent restoration:

D-5	1837	GLO	Whitcomb	Set Post
	1954	Kent Co. Wits		3/4" Iron in Mon. Box
	1981	LCRC #2090	Nederveld	Iron in Mon. Box
	1982	LCRC #2880	Jonker	Set Kent County Monument
	1990	LCRC #5654	Marschall	Kent County Monument

The position of this corner was previously approved by the Kent County Remonumentation Peer Group, monumented by Robert J. Jonker on 5-27-82 and was recorded per LCRC #2880.

B. Description of corner evidence found and/or method applied in restoring or reestablishing corner:

D-5 Found Kent County Monument (Harrison) per witnesses from above LCRC as set by Robert J. Jonker in place of the 3/4" Iron in a Mon. Box he found. Said Iron checks with Kent Co. Wits. and LCRC #2090.

LCRC #2880	Nail & Remon. tag T. Pole	S65°E	82.23'	"X" cut N. end conc. culv.	N60°W	58.06'
	Set chiseled "X" N. end culv.	N55°W	58.0'	Nail & Remon. tag Guy Pole	S22°W	91.18'
	Set chiseled "X" S. end culv.	S60°W	61.46'	Nail & Remon. tag P. Pole	S19°E	88.03'
	C/L top R.O.W. marker	N80°E	121.4'	Nail & Remon. tag P. Pole	N70°E	66.44'
	On C/L "X" intersection					

C. Description of monument for corner and accessories established to perpetuate locating the position of the corner:

D-5 Standard Kent County Monument in Mon. Box	"X" cut top of N. end conc. culvert	N60°W	58.06'
	Nail & KC Remon. tag SE side Guy Pole	S22°W	91.21'
	Nail & KC Remon. tag W. side P. Pole	S19°E	88.08'
	Nail & KC Remon. tag S. side P. Pole	N70°E	65.97'
	On C/L "X" Intersection		


Signed by Kirk Breitels
Surveyor's Michigan License No. 30077

Date 2/19/98

STATE OF MICHIGAN
COUNTY OF KENT
RECORDED FOR RECORD
98 MAR -5 AM 8:32
REG. OF DEEDS
Lucy Standa

10517

Register of Deeds Stamp & File Number

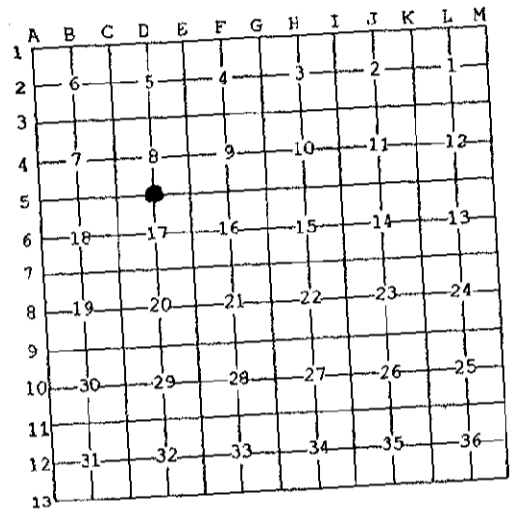

P.A. 345 1990 KENT COUNTY
PEER APPROVED 2/19/98
CHAIRMAN *Kenneth Huber*

