

SURVEY
COMMISSION

JAN 24 1996

LAND CORNER RECORDATION CERTIFICATE

COMMISSION

Filing Requirement of Act 74, Mich. P.A. 1970

For corners in

Kent

(County)

Located In:

Corner Code #

- | | | | | | |
|------------------------------------|---|-----------|---|------------|----------------------------------|
| 1. Public Land Survey | T | <u>9N</u> | R | <u>11W</u> | <u>D-10 Center of Section 29</u> |
| | T | | R | | |
| | T | | R | | |
| | T | | R | | |
| 2. Property Controlling in Section | S | | T | R | |
| | S | | T | R | |
| 3. Miscellaneous Property in Sec. | S | | T | R | |
| | S | | T | R | |

4. Lot No. _____, Recorded Plat _____
5. Private Claims _____

I, Wallace E. Glaza in a field survey on October 16, 19 95, do hereby certify that under requirements of P.A. 74, Michigan P.A. of 1970, the corner points mentioned in lines 1 and 2 above were in conformance with regulations and rules therefore as required in the current manual of survey instructions of the United States Department of the Interior, Bureau of Land Management or by a decree of a Court of Law and/or that the corner points mentioned in lines 3, 4 and 5 above were in conformance with the rules of the Michigan Board of Land Surveyors or by a Decree of a Court of Law; established, re-established, monumented, re-monumented, recovered, found as expressed below:

NOTE: Not more than 4 corners, all in the same town and range, may be recorded on this certificate.

A. Description of original monument and accessories and/or subsequent restoration:

- | | | |
|------|------|---|
| 1937 | GLO | Not set |
| 1928 | W.W. | Intersected $\frac{1}{4}$ lines and set iron for center |
| | | 24" Maple E 97.6' |
| | | 20" Poplar S 68.6' |
| | | NE cor school foundation SW 105.8' |
| | | SE cor store NW 79.35' |

- | | |
|------|--------------------------------|
| 1972 | LCRC No. 220 (W.W.) |
| | Found 2" iron |
| | NE cor conc bldg S55°W 124.66' |
| | MBT pole N45°E 50.52' |
| | 20" Maple S52°E 77.78' |

- | | | |
|-------|------|--|
| 1929- | | |
| 1978 | W.W. | Found iron at center /SW corner house foundation N50°E 111.94' |
| | | 20" Maple S52°E 77.78' /SE cor house foundation N50°W 109.20' |

B. Description of corner evidence found and/or method applied in restoring or reestablishing corner:

D-10 (Center of Section 29, T9N, R11W, Algoma Township, Kent County, Michigan)

Found 2" iron from W.W. witnesses: NE corner conc bldg S55°W 124.66'
20" Maple S52°E 77.78'

The 2" iron pipe has also been used in other surveys by various surveyors.

The 2" iron pipe is accepted by me and is generally accepted by professional surveyors as the best available evidence of the position of this corner.


2" iron is 4.3' East and 0.3' South of the intersection of the $\frac{1}{4}$ lines.

C. Description of monument for corner and accessories established to perpetuate locating the position of the corner:

D-10 Set 4" X 30" standard Harrison monument in place of 2" iron pipe.

- | | | |
|-----------------------------------|-------|---------|
| 1) Found NE corner conc. bldg. | S55°W | 124.66' |
| 2) Set tag & nail in MBT pole | N78°E | 71.96' |
| 3) Set tag & nail in 30" Maple | S52°E | 77.45' |
| 4) Cut "X" on E end conc. culvert | N68°W | 84.22' |
| 5) NE corner frame bldg | S50°W | 124.03' |


P.A. 345 1990 KENT COUNTY
PEER APPROVED 6/22/95
CHAIRMAN Harry Kubel

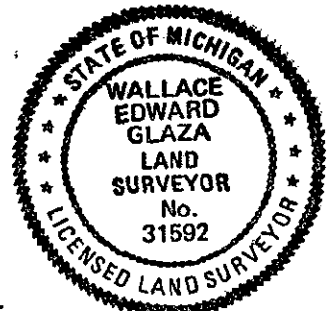

Signed by Wallace E. Glaza
Glaza & Associates, Inc.

Date 10-23-95

Surveyor's Michigan License No. 31592

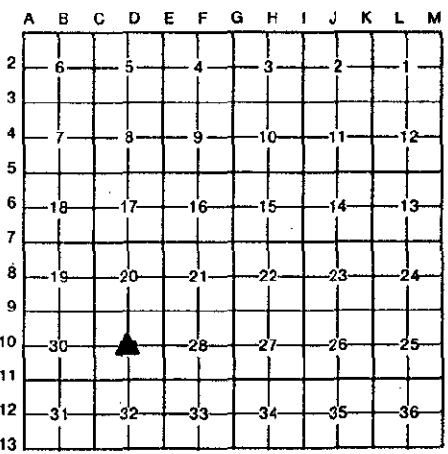

STATE OF MICHIGAN
COUNTY OF KENT
RECEIVED FOR RECORD
95 OCT 24 PM 4:08
REG. OF DEEDS
8717
Register of Deeds Stamp & File Number