SURVEY & REMONUMENTATION

$7.00
$2.00

MAR 08 1999

KENT COUNTY REMONUMENTATION

LAND CORNER RECORDATION CERTIFICATE
Filing Requirement of Act 74, Mich. P.A. 1970

STATE OF MICHIGAN
COUNTY OF KENT
RECEIVED FOR RECORD
98 MAY 21 AM 8:31
REG. OF DEEDS

10603
Register of Deeds Stamp & File Number

For corners in

KENT COUNTY (County) Located In: Corner Code #

1. Public Land Survey		T 9N	R 11W	D-11
		T___	R___	
		T___	R___	
		T___	R___	
2. Property Controlling	S___	T___	R___	
in Section	S___	T___	R___	
3. Miscellaneous	S___	T___	R___	
Property in Sec.	S___	T___	R___	

4. Lot No. _____ , Recorded Plat _____
5. Private Claims _____

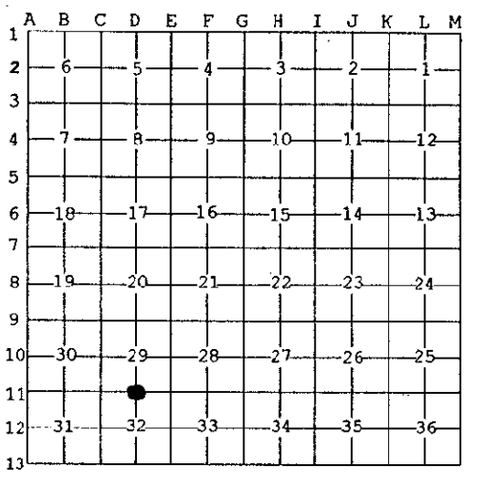

I, Kirk Breitels, in a field survey on April 7, 19 98 do hereby state that under requirements of P.A. 74, Michigan P.A. of 1970, the corner points mentioned in lines 1 and 2 above were in conformance with regulations and rules therefore as required in the current manual of survey instructions of the United States Department of the Interior, Bureau of Land Management or by a decree of a Court of Law and /or that the corner points mentioned in lines 3, 4 and 5 above were in conformance with the rules of the Michigan Board of Land Surveyors or by a Decree of a Court of Law; established, re-established, monumented, recovered, found as expressed below:

NOTE: Not more than 2 corners, all in the same town and range, may be recorded on this certificate.

A. Description of original monument and accessories and/or subsequent restoration:

D-11	1837	GLO	Whitcomb	Set Post
	1967	Kent Co. Wits		3/4" Iron
	1973	LCRC #475	Spicer	1" Iron in Mon. Box
	1981	LCRC #2461	Jonker	Set Kent County Monument in Mon. Box
	1990	LCRC #5656	Marschall	Kent County Monument

P.A. 345 1990 KENT COUNTY
PEER APPROVED 4/30/98
CHAIRMAN Harry J. Huber

The position of this corner was previously approved by the Kent County Remonumentation Peer Group, monumented by Robert J. Jonker on 11-20-81 and was recorded per LCRC #2461.

B. Description of corner evidence found and/or method applied in restoring or reestablishing corner:

D-11 Found Kent County Monument (Harrison) per witnesses from above LCRC as set by Robert J. Jonker in place of the 1" Iron he found over a Stone inside a Mon. Box. Said Iron over Stone checks with Kent Co. Wit. and LCRC #475.

LCRC #2461			LCRC #5656		
Nail & Remon. tag T. Pole	N34°E	61.85'	Nail & Remon. tag 36" Oak	S02°W	72.57'
Nail & Remon. tag 12" Pine	S37°E	77.55'	Nail & Remon. tag 14" Pine	S40°E	77.53'
Nail & Remon. tag 32" Oak	S04°W	72.64'	Nail & Remon. tag T. Pole	N32°E	61.83'
Nail & Remon. tag Tw. 14" Poplar	N14°W	111.70'	Nail & Remon. tag 8" Walnut	S68°W	78.61'
C/L E-W pavement 2' South			C/L E-W pavement 2' South		
On line C/L gravel to North			C/L road going North		

The selected location is accepted by me and is generally accepted by professional surveyors as the best available evidence of the position of the original corner.

C. Description of monument for corner and accessories established to perpetuate locating the position of the corner:

D-11 Standard Kent County Monument

Nail & KC Remon. tag E. side 42" Oak	S02°W	72.60'
Nail & KC Remon. tag W. side 16" Pine	S40°E	77.53'
Nail & KC Remon. tag W. side T. Pole	N32°E	61.88'
Nail & KC Remon. tag N. side 12" Walnut	S68°W	78.63'

C/L E-W pavement is 2' South
On C/L road running North

STATE OF MICHIGAN
KIRK BREITELS
LAND SURVEYOR
NO 30077
LICENSED LAND SURVEYOR

Signed by Kirk Breitels

Date 4/30/98

Surveyor's Michigan License No. 30077

FORM APPROVED BY MICHIGAN STATE BOARD OF PROFESSIONAL SURVEYORS, JAN. 28, 1971
REVISED MAY 14,1975
REVISED JAN., 1983
REVISED OCT., 1995