SURVEY & REMONUMENTATION

$7.00
$2.00

MAR 0 8 1999

SECTION

KENT COUNTY REMONUMENTATION

LAND CORNER RECORDATION CERTIFICATE
Filing Requirement of Act 74, Mich. P.A. 1970

STATE OF MICHIGAN
COUNTY OF KENT
RECEIVED FOR RECORD
98 MAR -5 AM 8: 32
REG. OF DEEDS

10521
Register of Deeds Stamp & File Number

For corners in
KENT COUNTY
(County)

Located In: Corner Code #

1. Public Land Survey — T 9N R 11W — E-2
   T___ R___
   T___ R___
   T___ R___
2. Property Controlling in Section — S___ T___ R___
   S___ T___ R___
3. Miscellaneous Property in Sec. — S___ T___ R___
   S___ T___ R___

4. Lot No. _____, Recorded Plat _____
5. Private Claims _____

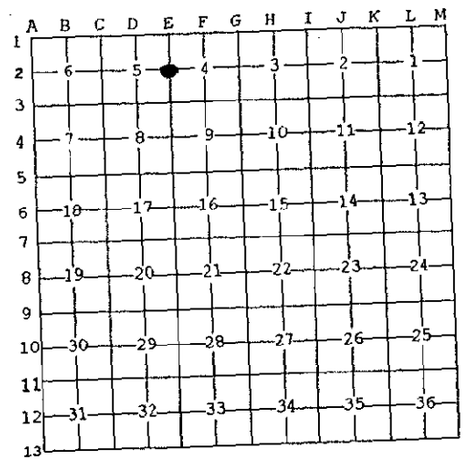

I, Kirk Breitels, in a field survey on Jan. 7, 19 98 do hereby state that under requirements of P.A. 74, Michigan P.A. of 1970, the corner points mentioned in lines 1 and 2 above were in conformance with regulations and rules therefore as required in the current manual of survey instructions of the United States Department of the Interior, Bureau of Land Management or by a decree of a Court of Law and /or that the corner points mentioned in lines 3, 4 and 5 above were in conformance with the rules of the Michigan Board of Land Surveyors or by a Decree of a Court of Law; established, re-established, monumented, recovered, found as expressed below:

NOTE: Not more than 2 corners, all in the same town and range, may be recorded on this certificate.

A. Description of original monument and accessories and/or subsequent restoration:

E-2	1837	GLO	Whitcomb	Set Post
	1970	Kent Co. Wits		Concrete Monument
	1979	LCRC #1279	Hackbardt	PK Nail
	1981	LCRC #2462	Jonker	Set Kent County Monument
	1990	LCRC #5660	Marschall	Kent County Monument

P.A. 345 1990 KENT COUNTY
PEER APPROVED 2/19/98
CHAIRMAN Larry Huber

The position of this corner was previously approved by the Kent County Remonumentation Peer Group, monumented by Robert J. Jonker on 11-20-81 and was recorded per LCRC #2462.

B. Description of corner evidence found and/or method applied in restoring or reestablishing corner:

E-2 Found Kent County Monument (Harrison) per witnesses from above LCRC as set by Robert J. Jonker in place of the PK Nail he found. Said PK Nail checks with Kent Co. Wits. and LCRC #1279.

LCRC #2462
- Nail & Remon. tag 24" Oak N16°E 107.55'
- Nail & Remon. tag 8" Ash S43°E 80.42'
- Nail & Remon. tag 8" Ash S18°W 108.13'
- Nail & Remon. tag P. Pole N59°E 131.00'
- C/L "X" pavement is 3' E. and 3' South

LCRC #5660
- Nail & Remon. tag 28" Oak N10°E 107.22'
- Nail & Remon. tag 38" Oak N10°W 145.99'
- Nail & Remon. tag P.P. N38°E 94.07'
- Nail & Remon. tag 16" Ash S63°E 123.82'

The selected location is accepted by me and is generally accepted by professional surveyors as the best available evidence of the position of the original corner.

C. Description of monument for corner and accessories established to perpetuate locating the position of the corner:

E-2 Standard Kent County Monument
- Nail & KC Remon. tag W. side 32" Oak N10°E 107.32'
- Nail & KC Remon. tag W. side 42" Oak N10°W 146.04'
- Nail & KC Remon. tag W. side P. Pole N38°E 94.18'
- Nail & KC Remon. tag NE side 22" Ash S63°E 123.88'
- Nail & KC Remon. tag W. side 6" Elm S30°E 71.40'

STATE OF MICHIGAN
KIRK BREITELS
LAND SURVEYOR
NO
30077
LICENSED LAND SURVEYOR

Signed by Kirk Breitels
Surveyor's Michigan License No. 30077

Date 2/19/98

FORM APPROVED BY MICHIGAN STATE BOARD OF PROFESSIONAL SURVEYORS, JAN. 28, 1971
REVISED MAY 14, 1975
REVISED JAN., 1983
REVISED OCT., 1995