

MAR 08 1999

KENT COUNTY REMONUMENTATION

LAND CORNER RECORDATION CERTIFICATE
Filing Requirement of Act 74, Mich. P.A. 1970

\$7.00
\$2.00

SECTION

STATE OF MICHIGAN
COUNTY OF KENT
RECEIVED FOR RECORD
98 MAR -5 AM 8:32
REG. OF DEEDS
Barry St. John

For corners in

KENT COUNTY
(County)

Located In:

Corner Code #

1. Public Land Survey

T 9N R 11W

E-5

T R

T R

T R

T R

2. Property Controlling in Section

S

T R

S

T R

3. Miscellaneous Property in Sec.

S

T R

S

T R


10522

Register of Deeds Stamp & File Number

4. Lot No. _____, Recorded Plat _____
5. Private Claims _____

I, Kirk Breitels, in a field survey on Jan. 7, 19 98 do hereby state that under requirements of P.A. 74, Michigan P.A. of 1970, the corner points mentioned in lines 1 and 2 above were in conformance with regulations and rules therefore as required in the current manual of survey instructions of the United States Department of the Interior, Bureau of Land Management or by a decree of a Court of Law and/or that the corner points mentioned in lines 3, 4 and 5 above were in conformance with the rules of the Michigan Board of Land Surveyors or by a Decree of a Court of Law; established, re-established, monumented, recovered, found as expressed below:

NOTE: Not more than 2 corners, all in the same town and range, may be recorded on this certificate.

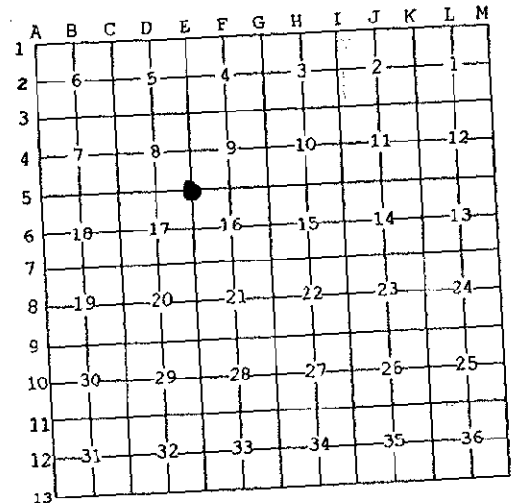

A. Description of original monument and accessories and/or subsequent restoration:

E-5	1837	GLO	Whitcomb	Set Post
	1967	MSHD		3/4" Iron
	1969	Kent Co. Wits		3/4" Iron
	1983	LCRC #3672	Bueche	Set Kent County Monument
	1990	LCRC #5663	Marschall	Kent Co. Mon.

P.A. 345 1990 KENT COUNTY

PEER APPROVED 2/19/98

CHAIRMAN *[Signature]*

The position of this corner was previously approved by the Kent County Remonumentation Peer Group, monumented by John C. Bueche on 12-12-83 and was recorded per LCRC #3672.

B. Description of corner evidence found and/or method applied in restoring or reestablishing corner:

E-5 Found Kent County Monument (Harrison) per witnesses from above LCRC as set by John C. Bueche in place of the rebar over another Iron he found. Both Irons checks with MSHD and Kent Co. Wits.

LCRC #3672	"X" cut in conc. culvert S30°W 29.54'	LCRC #5663	"X" cut top 18" conc. culv. S26°W 29.68'
	"X" cut in conc. culvert N40°W 35.29'		"X" cut top 18" conc. culv. N44°W 35.35'
	PK Nail in CMP S75°W 60.65'		PK in top 15" CMP culv. S70°E 71.09'
	PK Nail in CMP S65°E 71.10'		PK in top 15" CMP culv. N71°E 72.06'
	PK Nail in CMP N75°E 72.07'		PK in top 15" CMP culv. S71°W 60.68'

On fence line S. - On C/L blacktop road E-W - C/L gravel road N. is East 10'±
The selected location is accepted by me and is generally accepted by professional surveyors as the best available evidence of the position of the original corner.

C. Description of monument for corner and accessories established to perpetuate locating the position of the corner:

E-5 Standard Kent County Monument	"X" cut in top of 18" conc. culvert	S26°W 29.68'
	"X" cut in top of 18" conc. culvert	N44°W 35.35'
	PK in top of S. end 15" CMP culvert	S70°E 71.09'
	PK in top of N. end 15" CMP culvert	N71°E 72.06'
	PK in top of W. end 15" CMP culvert	S71°W 60.68'



Signed by

[Signature]

Surveyor's Michigan License No. 30077

Date

2/19/98