

SURVEY & REMONUMENTATION

\$7.00
\$2.00

MAR 08 1999

KENT COUNTY REMONUMENTATION

LAND CORNER RECORDATION CERTIFICATE
Filing Requirement of Act 74, Mich. P.A. 1970

STATE OF MICHIGAN
COUNTY OF KENT
RECEIVED FOR RECORD
98 MAR -5 AM 8:32
REG. OF DEEDS
Lucy Bond

For corners in

KENT COUNTY
(County)

Located In:

Corner Code #

1. Public Land Survey	T <u>9</u> N	R <u>11</u> W	<u>E-8</u>
	T _____	R _____	_____
	T _____	R _____	_____
	T _____	R _____	_____
2. Property Controlling in Section	S _____	T _____	R _____
	S _____	T _____	R _____
3. Miscellaneous Property in Sec.	S _____	T _____	R _____
	S _____	T _____	R _____

10524

Register of Deeds Stamp & File Number

4. Lot No. _____, Recorded Plat _____
5. Private Claims _____

I, Kirk Breitels, in a field survey on Jan. 7, 19 98 do hereby state that under requirements of P.A. 74, Michigan P.A. of 1970, the corner points mentioned in lines 1 and 2 above were in conformance with regulations and rules therefore as required in the current manual of survey instructions of the United States Department of the Interior, Bureau of Land Management or by a decree of a Court of Law and /or that the corner points mentioned in lines 3, 4 and 5 above were in conformance with the rules of the Michigan Board of Land Surveyors or by a Decree of a Court of Law; established, re-established, monumented, recovered, found as expressed below:

NOTE: Not more than 2 corners, all in the same town and range, may be recorded on this certificate.

A	B	C	D	E	F	G	H	I	J	K	L	M
1												
2	6		5		4		3		2		1	
3												
4	7		8		9		10		11		12	
5												
6	10		17		16		15		14		13	
7												
8	19		20	●	21		22		23		24	
9												
10	30		29		28		27		26		25	
11												
12	31		32		33		34		35		36	
13												

A. Description of original monument and accessories and/or subsequent restoration:

- E-8 1837 GLO Whitcomb Set Post
- 1879-98 Williams & Works Post - replaced with Leaded Stone
- 1946 Kent Co. Wits 3" Iron
- 1983 LCRC #3652 Bueche Set Kent County Monument
- 1990 LCRC #5666 Marshall Kent Co. Mon.

P.A. 345 1990 KENT COUNTY
PEER APPROVED 2/19/98
CHAIRMAN *Harry Stuber*

The position of this corner was previously approved by the Kent County Remonumentation Peer Group, monumented by John C. Bueche on 11-21-83 and was recorded per LCRC #3652.

B. Description of corner evidence found and/or method applied in restoring or reestablishing corner:


E-8 Found Kent County Monument (Harrison) per witnesses from above LCRC as set by John C. Bueche in place of the 3" Iron he found. Said Iron checks with Kent Co. Wits.

LCRC #3652	LCRC #5666
Nail & Remon. tag 15" Cherry S60°E 53.48'	Nail & Remon. tag Twin 28" Ash N02°E 40.44'
Nail & Remon. tag P. Pole S35°E 43.05'	Nail & Remon. tag 20" Cherry S60°E 53.48'
Nail & Remon. tag 28" Oak S05°W 36.62'	Nail & Remon. tag P.P. S40°E 43.03'
PK Nail 36" Oak N00°E 40.50'	Nail & Remon. tag 32" Oak S05°W 38.58'
SE cor. hse. frame N30°W 87.41'	
C/L gravel road E-W is South 6' ±	

The selected location is accepted by me and is generally accepted by professional surveyors as the best available evidence of the position of the original corner.

C. Description of monument for corner and accessories established to perpetuate locating the position of the corner:

- E-8 Standard Kent County Monument
- Nail & KC Remon. tag E. side Twin 30" Ash N02°E 40.44'
- Nail & KC Remon. tag NE side 24" Cherry S60°E 53.55'
- Nail & KC Remon. tag SW side P. Pole S40°E 43.12'
- Nail & KC Remon. tag W. side 36" Oak S05°W 38.60'

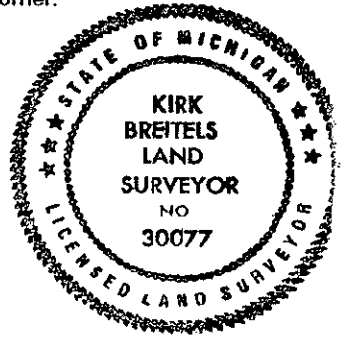

Signed by *Kirk Breitels*
Surveyor's Michigan License No. 30077

Date 2/19/98