

Survey & Remonumentation

MAR 08 1999

KENT COUNTY REMONUMENTATION

STATE OF MICHIGAN  
COUNTY OF KENT  
RECEIVED FOR RECORD

98 JUL 14 AM 9:54

LAND CORNER RECORDATION CERTIFICATE  
Filing Requirement of Act 74, Mich. P.A. 1970

*W. J. Bond*  
REG. OF DEEDS

\$7.00  
\$2.00

SECTION

For corners in

KENT COUNTY  
(County)

Located In:

Corner Code #

1. Public Land Survey

T 9N R 11W E-9  
T R  
T R  
T R

2. Property Controlling in Section


S T R  
S T R  
S T R  
S T R

3. Miscellaneous Property in Sec.

4. Lot No. \_\_\_\_\_, Recorded Plat \_\_\_\_\_  
5. Private Claims \_\_\_\_\_

I, Kirk Breitels, in a field survey on May 8, 1998 do hereby state that under requirements of P.A. 74, Michigan P.A. of 1970, the corner points mentioned in lines 1 and 2 above were in conformance with regulations and rules therefore as required in the current manual of survey instructions of the United States Department of the Interior, Bureau of Land Management or by a decree of a Court of Law and/or that the corner points mentioned in lines 3, 4 and 5 above were in conformance with the rules of the Michigan Board of Land Surveyors or by a Decree of a Court of Law, established, re-established, monumented, recovered, found as expressed below:

NOTE: Not more than 2 corners, all in the same town and range, may be recorded on this certificate.

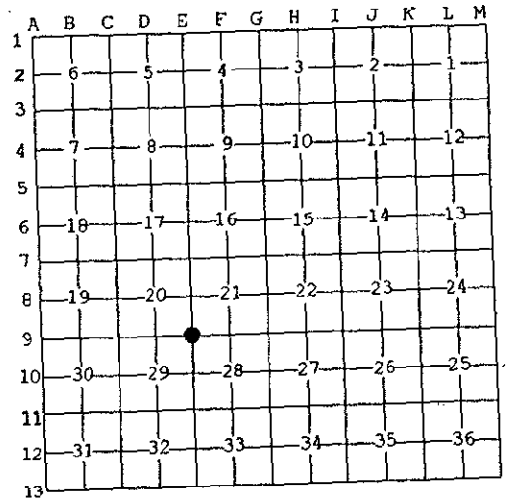

A. Description of original monument and accessories and/or subsequent restoration:

E-9 1837 GLO Whitecomb Set Post  
Kent Co. Wits Stone  
1879-1964 Williams & Works Stone - Set Iron  
1984 LCRC #3804 Bueche Set Kent County Monument  
1990 LCRC #5667 Marschall Kent County Monument

P.A. 345 1990 KENT COUNTY  
PEER APPROVED 6/25/98  
CHAIRMAN Harry J. Hubert

The position of this corner was previously approved by the Kent County Remonumentation Peer Group, monumented by John C. Bueche on 4-21-84 and was recorded per LCRC #3804.

B. Description of corner evidence found and/or method applied in restoring or reestablishing corner:

E-9 Found Kent County Monument (Harrison) per witnesses from above LCRC as set by John C. Bueche. Said location was established per Williams & Works information. No iron was found. Stone was found lying in nearby creek.  
LCRC #3804

LCRC #5667  
Nail & Remon. tag 8" Poplar S10°W 51.30' Nail & Remon. tag 36" Oak S45°W 32.12'  
Nail & Remon. tag 36" Oak S35°W 32.25' Nail & Remon. tag 6" Ash S10°E 43.72'  
Nail & Remon. tag 6" Elm N60°W 37.10' Nail & Remon. tag 10" Ash S55°E 48.17'  
Nail & Remon. tag 8" Poplar S80°W 41.90' Nail & Remon. tag 16" Oak N40°E 29.23'  
Nail & Remon. tag 14" Oak N40°E 29.22' Nail & Remon. tag 8" Poplar S10°E 51.38'  
Nail & Remon. tag 10" Elm N90°E 54.75'

The selected location is accepted by me and is generally accepted by professional surveyors as the best available evidence of the position of the original corner.

C. Description of monument for corner and accessories established to perpetuate locating the position of the corner:

E-9 Standard Kent County Monument  
Nail & KC Remon. tag E. side 38" Oak S45°W 32.02'  
Nail & KC Remon. tag W. side 10" Ash S10°E 43.70'  
Nail & KC Remon. tag N. side 12" Ash S55°E 48.14'  
Nail & KC Remon. tag W. side 20" Elm N40°E 29.13'  
Nail & KC Remon. tag E. side dead 8" Poplar S10°W 51.38'  
Monument is in swampy area and is at S. edge of 4' wide creek



Signed by Kirk Breitels  
Surveyor's Michigan License No. 30077

Date 6/25/98