

**SURVEY &
REMONUMENTATION**

KENT COUNTY REMONUMENTATION

FEB 14 1997

**LAND CORNER RECORDATION CERTIFICATE
Filing Requirement of Act 74, Mich. P.A. 1970**

COMMISSION

For corners in
KENT COUNTY

Located In:	Corner Code #
T 9N R 11W	E-13
T R	
T R	
T R	
S T R	
S T R	
S T R	
S T R	

STATE OF MICHIGAN
COUNTY OF KENT
RECEIVED FOR RECORD

96 MAR 20 AM 9:00

REG. OF DEEDS

Luci Standa

9133

Register of Deeds Stamp & File Number

- 1. Public Land Survey
- 2. Property Controlling in Section
- 3. Miscellaneous Property in Sec.
- 4. Lot No. _____, Recorded Plat _____
- 5. Private Claims _____

I, Kirk Breitels, in a field survey on Jan. 25, 19 96 do hereby state that under requirements of P.A. 74, Michigan P.A. of 1970, the corner points mentioned in lines 1 and 2 above were in conformance with regulations and rules therefore as required in the current manual of survey instructions of the United States Department of the Interior, Bureau of Land Management or by a decree of a Court of Law and /or that the corner points mentioned in lines 3, 4 and 5 above were in conformance with the rules of the Michigan Board of Land Surveyors or by a Decree of a Court of Law; established, re-established, monumented, recovered, found as expressed below:

NOTE: Not more than 2 corners, all in the same town and range, may be recorded on this certificate.

	A	B	C	D	E	F	G	H	I	J	K	L	M
1													
2	6		5		4		3		2		1		
3													
4	7		8		9		10		11		12		
5													
6	18		17		16		15		14		13		
7													
8	19		20		21		22		23		24		
9													
10	30		29		28		27		26		25		
11													
12	31		32		33		34		35		36		
13													

- A. Description of original monument and accessories and/or subsequent restoration:
- | | | | | |
|------|-----------|------------------|------------|--------------------------|
| E-13 | 1837 | GLO | Brookfield | Set Post |
| | 1944 | Kent Co. Wit. | | 2" Pipe-Mon. Box |
| | 1899-1668 | Williams & Works | | Mon. Box |
| | 1984 | LCRC #4029 | Byl | Set Kent County Monument |
| | 1990 | LCRC #5671 | Marschall | Kent County Monument |


P.A. 345 1990 KENT COUNTY
PEER APPROVED 3/7/96
CHAIRMAN *Ray Stuber*

The position of this corner was previously approved by the Kent County Remonumentation Peer Group, monumented by William R. Byl on 11/7/84 and was recorded per LCRC #4029.

- B. Description of corner evidence found and/or method applied in restoring or reestablishing corner:
- E-13 Found standard Kent Co. Mon. (Harrison) per witnesses from above LCRC as set by William R. Byl in place of the 1" Iron Pipe he found inside a Mon. Box. Said Iron Pipe checks with Williams & Works and Kent Co. Wit.
- | | | | |
|-------------------|---------------------------------|---------------------------------|--------------------------------|
| <u>LCRC #4029</u> | NE cor. hse. fnd. S30°E 163.10' | NW cor. gar. fnd. S28°W 191.55' | Nail/tag P. Pole |
| | NE cor. conc. ped. S00°W 93.93' | SW cor. hse. fnd. N37°W 134.17' | N08°E 40.89' |
| | SW cor. hse. fnd. N40°W 134.17' | SE cor. hse. fnd. N48°E 174.98' | E-1, T8N, R11W |
| | SW cor. hse. fnd. N40°E 153.87' | Nail/tag P. Pole South 125.75' | |
| | PP N10°E 40.87' | PP N30°E 104.18' | Nail/tag P. Pole N32°E 104.15' |

The selected location is accepted by me and is generally accepted by professional surveyors as the best available evidence of the position of the original corner.

- C. Description of monument for corner and accessories established to perpetuate locating the position of the corner:
- | | | | |
|--------------------------------------|-------|---------|--|
| E-13 Standard Kent County Monument | | | |
| Nail & KC Remon. tag E. side P. Pole | South | 125.75' | |
| Nail & KC Remon. tag E. side P. Pole | N32°E | 104.15' | |
| Nail & KC Remon. tag W. side P. Pole | N08°E | 40.89' | |
| NW corner garage foundation (#1553) | S28°W | 191.55' | |
| SW corner house foundation | N37°W | 134.17' | |
| SE corner house foundation | N48°E | 174.98' | |
| Kent Co. Mon. (E-1, T8N, R11W) | East | 407.23' | |

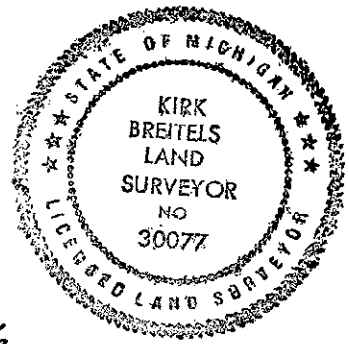

Signed by *Kirk Breitels* Date 3/1/96
Surveyor's Michigan License No. 30077