

LAND CORNER RECORDATION CERTIFICATE  
Filing Requirement of Act 74, Mich. P.A. 1970

SECTION

For corners in

KENT COUNTY  
(County)

Located In:

Corner Code #

- 1. Public Land Survey      T9N R11W      F-1
- T      R
- T      R
- T      R
- T      R
- 2. Property Controlling    S      T      R
- in Section                S      T      R
- 3. Miscellaneous         S      T      R
- Property in Sec.        S      T      R

- 4. Lot No. \_\_\_\_\_, Recorded Plat \_\_\_\_\_
- 5. Private Claims \_\_\_\_\_

I, Kirk Breitels, in a field survey on Feb. 26, 1998 do hereby state that under requirements of P.A. 74, Michigan P.A. of 1970, the corner points mentioned in lines 1 and 2 above were in conformance with regulations and rules therefore as required in the current manual of survey instructions of the United States Department of the Interior, Bureau of Land Management or by a decree of a Court of Law and/or that the corner points mentioned in lines 3, 4 and 5 above were in conformance with the rules of the Michigan Board of Land Surveyors or by a Decree of a Court of Law; established, re-established, monumented, recovered, found as expressed below:

NOTE: Not more than 2 corners, all in the same town and range, may be recorded on this certificate.

A. Description of original monument and accessories and/or subsequent restoration:

- F-1 1837 GLO Whitcomb Not Set
- 1894 Williams & Works Old stake under stone - 236.28' W. of F-13, T10N, R11W
- 1979: LCRC #1279 Hackbardt 1/2" Rod
- 1996 LCRC #9591 Breitels Set Kent County Monument

The position of this corner was previously approved by the Kent County Remonumentation Peer Group, monumented by Kirk Breitels on 12-12-96 and was recorded per LCRC #9591.

B. Description of corner evidence found and/or method applied in restoring or reestablishing corner:

F-1 Found Kent County Monument (Harrison) per witnesses from above LCRC as set by Kirk Breitels on Township Line in place of the Stone over remains of a wood stake he found. Said Stone over Stake checks with measurements by Williams & Works along Twp. Line. 1/2" Rod per LCRC #1279 is East 3.43' LCRC #9591


- Nail & KC Remon. tag NE side 28" Walnut N45°W 50.27'
- SW corner conc. blk. shed N25°W 132.10'
- Nail & KC Remon. tag SE side 30" Walnut N55°E 45.32'
- PK Nail E. side P. Pole S05°W 45.37'
- Kent Co. Mon. (F-13, T10N, R11W) East 235.84' Rerod - East 3.43'

P.A. 345 1990 KENT COUNTY  
PEER APPROVED 4/30/98  
CHAIRMAN Harry Huber

The selected location is accepted by me and is generally accepted by professional surveyors as the best available evidence of the position of the corner.

C. Description of monument for corner and accessories established to perpetuate locating the position of the corner:

- F-1 Standard Kent County Monument
- Nail & KC Remon. tag NE side 28" Walnut N45°W 50.27'
- SW corner concrete block shed N25°W 132.10'
- Nail & KC Remon. tag SE side 30" Walnut N55°E 45.35'
- PK Nail E. side P. Pole S05°W 45.37'
- Kent Co. Mon. (F-13, T10N, R11W) East 235.84'
- Rerod - East 3.43'

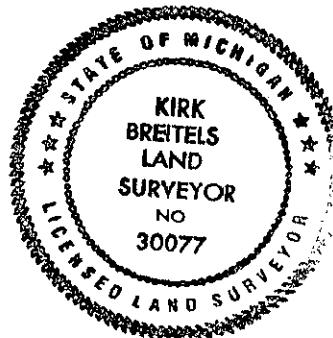

Signed by Kirk Breitels  
Surveyor's Michigan License No. 30077

Date 4/30/98

STATE OF MICHIGAN  
COUNTY OF KENT  
RECEIVED FOR RECORDING  
98 MAY 21 AM 8:31  
REG. OF DEEDS  
*Lucy St. James*

10008  
Register of Deeds Stamp & File Number

A	B	C	D	E	F	G	H	I	J	K	L	M
1												
2	6		5		4		3		2		1	
3												
4	7		8		9		10		11		12	
5												
6	18		17		16		15		14		13	
7												
8	19		20		21		22		23		24	
9												
10	30		29		28		27		26		25	
11												
12	31		32		33		34		35		36	
13												