

SURVEY & REMONUMENTATION

\$7.00
\$2.00

MAR 08 1999

KENT COUNTY REMONUMENTATION

LAND CORNER RECORDATION CERTIFICATE
Filing Requirement of Act 74, Mich. P.A. 1970

STATE OF MICHIGAN
COUNTY OF KENT
RECEIVED FOR RECORD
38 NOV 16 AM 8:00
REG. OF DEEDS
W. J. [Signature]

SECTION

For corners in
KENT COUNTY

Located in: Corner Code #

1. Public Land Survey

T 9N R 11W F-6

2. Property Controlling in Section

S T R

3. Miscellaneous Property in Sec.

S T R

10917

Register of Deeds Stamp & File Number

4. Lot No. _____, Recorded Plat _____
5. Private Claims _____

A	B	C	D	E	F	G	H	I	J	K	L	M
1												
2	6		5		4		3		2		1	
3												
4	7		8		9		10		11		12	
5												
6	18		17		16		15		14		13	
7												
8	19		20		21		22		23		24	
9												
10	30		29		28		27		26		25	
11												
12	31		32		33		34		35		36	
13												

I, Kirk Breitels, in a field survey on Oct. 14, 1998 do hereby state that under requirements of P.A. 74, Michigan P.A. of 1970, the corner points mentioned in lines 1 and 2 above were in conformance with regulations and rules therefore as required in the current manual of survey instructions of the United States Department of the Interior, Bureau of Land Management or by a decree of a Court of Law and/or that the corner points mentioned in lines 3, 4 and 5 above were in conformance with the rules of the Michigan Board of Land Surveyors or by a Decree of a Court of Law; established, re-established, monumented, recovered, found as expressed below:

NOTE: Not more than 2 corners, all in the same town and range, may be recorded on this certificate.

A. Description of original monument and accessories and/or subsequent restoration:

F-6 1837	GLO	Not Set
	Williams & Works	No information
	Kent Co. Wits	No information

P.A. 345 1990 KENT COUNTY
PEER APPROVED 10/22/98
CHAIRMAN *[Signature]*


B. Description of corner evidence found and/or method applied in restoring or reestablishing corner:
F-6 Found Capped Rerod (HEI) that is 0.1' W. and less than 0.1' S. of intersection of 1/4 lines.

Limited work in this section by other surveyors, are holding intersection of 1/4 lines.

The Capped Rerod (HEI) is accepted by me and is generally accepted by professional surveyors as the best available evidence of the position of the corner.

C. Description of monument for corner and accessories established to perpetuate locating the position of the corner:
F-6 Set Standard Kent County Monument in place of the Capped Rerod (HEI)

Nail & KC Remon. tag N. side 12" Basswood	S85°W 35.31'
Nail & KC Remon. tag E. side 30" Maple	N35°E 22.42'
Nail & KC Remon. tag N. side 14" Maple	S85°E 20.76'
Nail & KC Remon. tag E. side 30" Maple	S25°E 34.75'
N-S fence is East 4'	
E-W fence is North 8'	

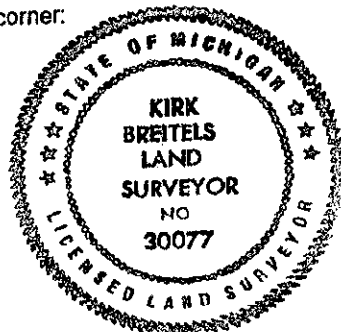

Signed by *[Signature]*
Surveyor's Michigan License No. 30077

Date 11/12/98