SURVEY & REMONUMENTATION

MAR 08 1999

$7.00
$2.00

SECTION

KENT COUNTY REMONUMENTATION

LAND CORNER RECORDATION CERTIFICATE
Filing Requirement of Act 74, Mich. P.A. 1970

STATE OF MICHIGAN COUNTY OF KENT RECEIVED FOR RECORD
98 MAR -5 AM 8:33
REG. OF DEEDS

10532
Register of Deeds Stamp & File Number

For corners in

KENT COUNTY (County) Located In: Corner Code #

1. Public Land Survey		T9N	R11W	G-2
		T___	R___	
		T___	R___	
		T___	R___	
2. Property Controlling	S___	T___	R___	
in Section	S___	T___	R___	
3. Miscellaneous	S___	T___	R___	
Property in Sec.	S___	T___	R___	

4. Lot No. _____ , Recorded Plat _____
5. Private Claims _____

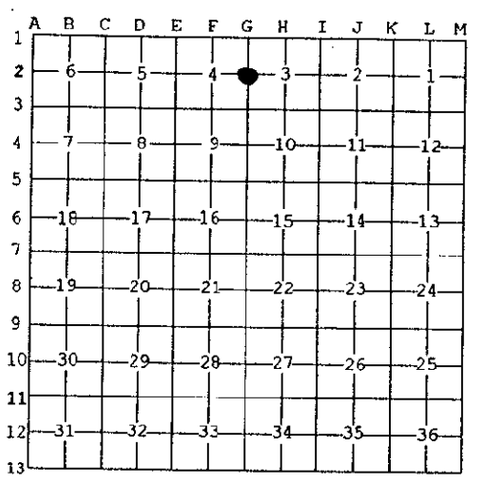

I, Kirk Breitels, in a field survey on Jan. 2, 1998 do hereby state that under requirements of P.A. 74, Michigan P.A. of 1970, the corner points mentioned in lines 1 and 2 above were in conformance with regulations and rules therefore as required in the current manual of survey instructions of the United States Department of the Interior, Bureau of Land Management or by a decree of a Court of Law and /or that the corner points mentioned in lines 3, 4 and 5 above were in conformance with the rules of the Michigan Board of Land Surveyors or by a Decree of a Court of Law; established, re-established, monumented, recovered, found as expressed below:

NOTE: Not more than 2 corners, all in the same town and range, may be recorded on this certificate.

A. Description of original monument and accessories and/or subsequent restoration:

G-2	1837	GLO	Whitcomb	Set Post
	1958	Kent Co. Wits		Mon. Box
	1976	LCRC #1010	Nederveld	Mon. Box
	1981	LCRC #2466	Jonker	Set Kent County Monument
	1990	LCRC #5680	Marschall	Kent County Monument

P.A. 345 1990 KENT COUNTY
PEER APPROVED 2/19/98
CHAIRMAN

The position of this corner was previously approved by the Kent County Remonumentation Peer Group, monumented by Robert J. Jonker on 11-20-81 and was recorded per LCRC #2466.

B. Description of corner evidence found and/or method applied in restoring or reestablishing corner:

G-2 Found Kent County Monument (Harrison) per witnesses from above LCRC as set by Robert J. Jonker in place of the ½" Iron he found inside a Mon. Box. Said Iron checks with Kent Co. Wits. and LCRC #1010.

LCRC #2466			LCRC #5680		
Nail & Remon. tag P. Pole	N25°E	96.32'	C/L top conc. R.O.W. marker	N16°W	121.48'
Nail & Remon. tag T. Pole	N59°W	59.08'	NW cor. 4'x20' conc. step	S26°E	80.26'
NE cor. hse. fnd.	S50°W	111.48'	NE cor. house foundation	S47°W	111.40'
NW cor. church fnd.	S25°E	82.05'	Nail & Remon. tag P. P.	N22°E	96.30'
C/L top conc R.O.W. marker On C/L "X" pavement	N12°W	121.44'	"X" in top end conc. culv..	S68°W	65.87'

The selected location is accepted by me and is generally accepted by professional surveyors as the best available evidence of the position of the original corner.

C. Description of monument for corner and accessories established to perpetuate locating the position of the corner:

G-2 Standard Kent County Monument in Mon. Box

C/L top conc R.O.W. marker	N16°W	121.48'
NW corner 4'x20' concrete step	S26°E	80.26'
NE corner house foundation	S47°W	111.48'
Nail & KC Remon. tag W. side P. Pole	N22°E	96.30'
"X" on top S. end conc. culvert	S68°W	65.84'

STATE OF MICHIGAN
KIRK BREITELS
LAND SURVEYOR
NO
30077
LICENSED LAND SURVEYOR

Signed by _____ Date 2/19/98

Surveyor's Michigan License No. 30077

FORM APPROVED BY MICHIGAN STATE BOARD OF PROFESSIONAL SURVEYORS, JAN. 28, 1971
REVISED MAY 14,1975
REVISED JAN., 1983
REVISED OCT., 1995