

\$7.00
\$2.00

MAR 03 1999

KENT COUNTY REMONUMENTATION

SECTION

LAND CORNER RECORDATION CERTIFICATE
Filing Requirement of Act 74, Mich. P.A. 1970

For corners in

KENT COUNTY

(County)

Located in:

Corner Code #

1. Public Land Survey

T 9N R 11W

G-7

T R

T R

T R

T R

2. Property Controlling in Section

S

T R

S

T R

3. Miscellaneous Property in Sec.

S

T R

S

T R

4. Lot No. _____, Recorded Plat _____

5. Private Claims _____

STATE OF MICHIGAN
COUNTY OF KENT
RECEIVED FOR RECORD
98 MAR -5 AM 8:33
REG. OF DEEDS
Lucy Hand

10536

Register of Deeds Stamp & File Number

I, Kirk Breitels, in a field survey on Jan. 28, 19 98 do hereby state that under requirements of P.A. 74, Michigan P.A. of 1970, the corner points mentioned in lines 1 and 2 above were in conformance with regulations and rules therefore as required in the current manual of survey instructions of the United States Department of the Interior, Bureau of Land Management or by a decree of a Court of Law and for that the corner points mentioned in lines 3, 4 and 5 above were in conformance with the rules of the Michigan Board of Land Surveyors or by a Decree of a Court of Law; established, re-established, monumented, recovered, found as expressed below:

NOTE: Not more than 2 corners, all in the same town and range, may be recorded on this certificate.

A. Description of original monument and accessories and/or subsequent restoration:

G-7	1837	GLO	Whitcomb	Set Post
	1970	Kent Co. Wits		Iron in Mon. Box
	1975	LCRC #883	Nederveld	Spike in Mon. Box
	1981	LCRC #2469	Jonker	Set Kent County Monument in Mon. Box
	1990	LCRC #5685	Marschall	Kent County Monument

The position of this corner was previously approved by the Kent County Remonumentation Peer Group, monumented by Robert J. Jonker on 11-17-81 and was recorded per LCRC #2469.

B. Description of corner evidence found and/or method applied in restoring or reestablishing corner:

G-7 Found Kent County Monument (Harrison) per witnesses from above LCRC as set by Robert J. Jonker in place of the Spike in a 1/2" Iron he found inside a Mon. Box. Both Spike and 1/2" Iron check with Kent Co. Wits. and LCRC #883. LCRC #2469

Nail & Remon. tag G. Pole	N56°W	76.45'	Nail & Remon. tag Guy pole	N60°W	76.32'
Nail & Remon. tag G. Pole	S55°E	67.76'	Nail & Remon. tag Light Pole	S59°E	67.77'
Nail & Remon. tag in curb joint	S32°W	53.40'	Nail & Remon. tag in curb joint	S29°W	53.40'
"X" on top curb	N48°E	48.02'	Top C/L conc R.O.W. marker	N56°E	108.22'
Nail & Remon. tag			Top C/L conc. project marker	N27°E	63.49'
			"X" in top of curb	N45°E	48.03'

The selected location is accepted by me and is generally accepted by professional surveyors as the best available evidence of the position of the original corner.

C. Description of monument for corner and accessories established to perpetuate locating the position of the corner:

G-7 Standard Kent County Monument in Mon. Box


Nail & KC Remon. tag SW side Guy Pole	N60°W	76.28'
Nail & KC Remon. tag NE side Guy Pole	S59°E	67.77'
Nail & KC Remon. tag in curb joint	S29°W	53.40'
Top C/L conc. R.O.W. marker	N56°E	108.22'
Top C/L conc. project marker	N27°E	63.49'
"X" in top of conc. curb	N45°E	48.03'

P.A. 345 1990 KENT COUNTY

PEER APPROVED 2/19/98

CHAIRMAN *Harry Huber*

1	A	B	C	D	E	F	G	H	I	J	K	L	M
2		6		5		4		3		2		1	
3													
4		7		8		9		10		11		12	
5													
6		18		17		16		15		14		13	
7													
8		19		20		21		22		23		24	
9													
10		30		29		28		27		26		25	
11													
12		31		32		33		34		35		36	
13													

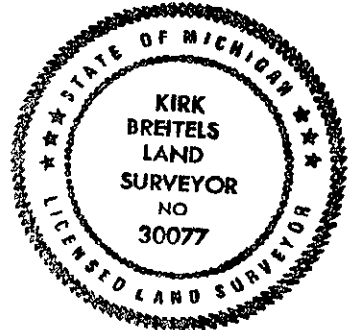

Signed by *Kirk Breitels*
Surveyor's Michigan License No. 30077

Date 2/19/98