SURVEY & REMONUMENTATION

$7.00
$2.00

MAR 0 8 1999

SECTION

KENT COUNTY REMONUMENTATION

LAND CORNER RECORDATION CERTIFICATE
Filing Requirement of Act 74, Mich. P.A. 1970

STATE OF MICHIGAN
COUNTY OF KENT
RECEIVED FOR RECORD
98 MAY 21 AM 8:31
REG. OF DEEDS

10611

Register of Deeds Stamp & File Number

For corners in

KENT COUNTY
(County)

	Located In:	Corner Code #
1. Public Land Survey	T 9N R 11W	G-11
	T___ R___	
	T___ R___	
	T___ R___	
2. Property Controlling	S___ T___ R___	
in Section	S___ T___ R___	
3. Miscellaneous	S___ T___ R___	
Property in Sec.	S___ T___ R___	

4. Lot No. _____ , Recorded Plat _____
5. Private Claims _____

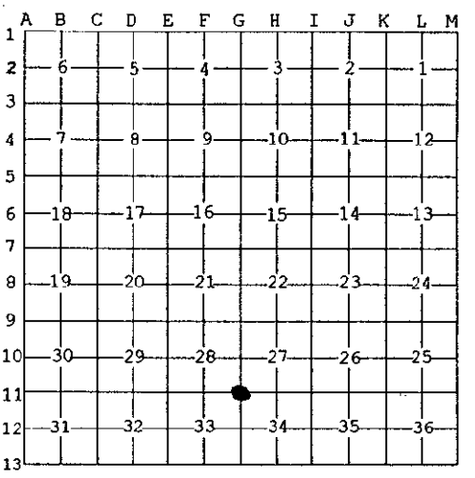

I, Kirk Breitels, in a field survey on April 7, 19 98 do hereby state that under requirements of P.A. 74, Michigan P.A. of 1970, the corner points mentioned in lines 1 and 2 above were in conformance with regulations and rules therefore as required in the current manual of survey instructions of the United States Department of the Interior, Bureau of Land Management or by a decree of a Court of Law and /or that the corner points mentioned in lines 3, 4 and 5 above were in conformance with the rules of the Michigan Board of Land Surveyors or by a Decree of a Court of Law; established, re-established, monumented, recovered, found as expressed below:

NOTE: Not more than 2 corners, all in the same town and range, may be recorded on this certificate.

A. Description of original monument and accessories and/or subsequent restoration:

G-11	1837	GLO	Whitcomb	Set Post
	1967	Kent Co. Wits		Mon. Box
	1972	LCRC #457	VanKooten	Iron in Mon. Box
	1977	LCRC #1079	McCloskey	3/4" Iron in Mon. Box
	1982	LCRC #2520	Starr	Set Kent County Monument in Mon. Box
	1990	LCRC #5689	Marschall	Kent County Monument

P.A. 345 1990 KENT COUNTY
PEER APPROVED 4/30/98
CHAIRMAN Harry Hubers

The position of this corner was previously approved by the Kent County Remonumentation Peer Group, monumented by Thomas C. Starr on 1-5-82 and was recorded per LCRC #2520.

B. Description of corner evidence found and/or method applied in restoring or reestablishing corner:

G-11 Found Kent County Monument (Harrison) per witnesses from above LCRC as set by Thomas C. Starr in place of the 3/4" Iron Pipe he found in a Mon. Box. Said Iron Pipe checks with Kent Co. Wits. and LCRC's #457 & #1079.

LCRC #2520			LCRC #5689		
Nail & Remon. tag T. Pole	N40°W	52.65'	Nail & Remon. tag 14" Oak	N73°W	113.98'
Nail & Remon. tag 8" Oak	N65°W	114.27'	Nail & Remon. tag 26" Oak	S45°W	80.98'
Nail & Remon. tag 20" Oak	S45°W	81.19'	Nail & Remon. tag 22" Oak	S15°W	126.67'
Nail & Remon. tag 20" Oak	S20°W	126.77'	"X" top conc. proj. marker	S15°E	104.33'
Nail & Remon. tag 3" Tw. Elm	N40°E	95.63'	Nail & Remon. tag 6" Hickory	N32°E	106.56'
"X" top conc. R/W mon.	N40°E	95.63'	Nail & Remon. tag T. Pole	N44°W	52.41'

The selected location is accepted by me and is generally accepted by professional surveyors as the best available evidence of the position of the original corner.

C. Description of monument for corner and accessories established to perpetuate locating the position of the corner:

G-11 Standard Kent County Monument

Nail & KC Remon. tag S. side 20" Oak	N73°W	114.01'
Nail & KC Remon. tag SE side 28" Oak	S45°W	80.83'
Nail & KC Remon. tag E. side 24" Oak	S15°W	126.84'
"X" in iron bar top of conc. project marker	S15°E	104.33'
Nail & KC Remon. tag W. side 8" Hickory	N32°E	106.67'
"X" top conc. curb	N45°W	36.25'

On C/L blacktop roads N-S & E-W

STATE OF MICHIGAN
KIRK BREITELS
LAND SURVEYOR
NO
30077
LICENSED LAND SURVEYOR

Signed by Kirk Breitels

Date 4/30/98

Surveyor's Michigan License No. 30077

FORM APPROVED BY MICHIGAN STATE BOARD OF PROFESSIONAL SURVEYORS, JAN. 28, 1971
REVISED MAY 14,1975
REVISED JAN., 1983
REVISED OCT., 1995