SURVEY & REMONUMENTATION

$7.00
$2.00

MAR 0 8 1999

SECTION

KENT COUNTY REMONUMENTATION

LAND CORNER RECORDATION CERTIFICATE
Filing Requirement of Act 74, Mich. P.A. 1970

For corners in

KENT COUNTY
(County)

Located in: Corner Code #

1. Public Land Survey		T 9N R 11W	H-1
		T___ R___	
		T___ R___	
		T___ R___	
2. Property Controlling in Section	S___	T___ R___	
	S___	T___ R___	
3. Miscellaneous Property in Sec.	S___	T___ R___	
	S___	T___ R___	

STATE OF MICHIGAN
COUNTY OF KENT
RECEIVED FOR RECORD
98 MAR -5 AM 8:33
REG. OF DEEDS

10539

Register of Deeds Stamp & File Number

4. Lot No. _____ , Recorded Plat _____
5. Private Claims _____

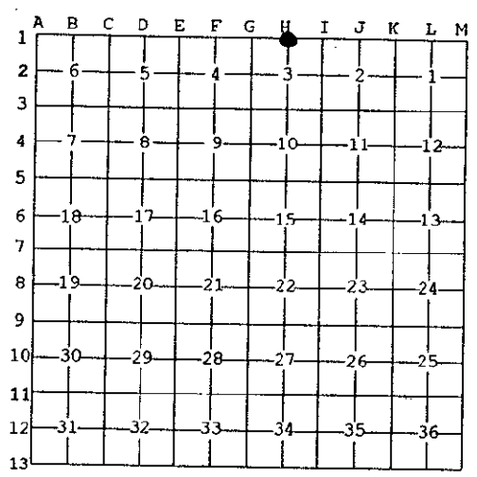

I, Kirk Breitels, in a field survey on Jan. 7, 19 98 do hereby state that under requirements of P.A. 74, Michigan P.A. of 1970, the corner points mentioned in lines 1 and 2 above were in conformance with regulations and rules therefore as required in the current manual of survey instructions of the United States Department of the Interior, Bureau of Land Management or by a decree of a Court of Law and /or that the corner points mentioned in lines 3, 4 and 5 above were in conformance with the rules of the Michigan Board of Land Surveyors or by a Decree of a Court of Law; established, re-established, monumented, recovered, found as expressed below:

NOTE: Not more than 2 corners, all in the same town and range, may be recorded on this certificate.

A. Description of original monument and accessories and/or subsequent restoration:

H-1	1837	GLO	Whitcomb	Not Set
	1893	Williams & Works		Set Stone midway of mile 187.44' W. of H-13, T10N, R11W
	1968	Consumers Power		Set corner
	1971	Williams & Works		Found Rerod 187.4' W. of H-13, T10N, R11W
	1976	LCRC #1009	VanKooten	Round Iron
	1996	LCRC #9592	Breitels	Set Kent County Monument

P.A. 345 1990 KENT COUNTY
PEER APPROVED 2/19/98
CHAIRMAN

The position of this corner was previously approved by the Kent County Remonumentation Peer Group, monumented by Kirk Breitels on 12-12-96 and was recorded per LCRC #9592.

B. Description of corner evidence found and/or method applied in restoring or reestablishing corner:

H-1 Found Kent County Monument (Harrison) per witnesses from above LCRC as set by Kirk Breitels on Township Line in place of the Reord he found. Said Rerod checks with Consumers Power and Williams & Works. Round Iron per LCRC #1009 is West 5.41'.
LCRC #9592.

Nail & KC Remon. tag SW side P. Pole	S50°E	80.22'	
C/L top MBT Box	S25°W	34.19'	
Nail & KC Remon. tag SW side 22" Walnut	N45°W	38.39'	
Nail & Remon. tag W. side 30" Walnut	N15°E	21.44'	Kent Co. Mon. (H-13, T10N, R11W)
SE corner stone fnd. Of house	N40°E	82.64'	East 187.47'

The selected location is accepted by me and is generally accepted by professional surveyors as the best available evidence of the position of the corner.

C. Description of monument for corner and accessories established to perpetuate locating the position of the corner:

H-1 Standard Kent County Monument

Nail & KC Remon. tag SW side P. Pole	S50°E	80.22'
C/L top Tele. Box	S25°W	34.19'
Nail & KC Remon. tag SW side 22" Walnut	N45°W	38.39'
Nail & KC Remon. tag W. side 30" Walnut	N15°E	21.44'
SE corner stone foundation of house	N40°E	82.64'

Iron Pipe - West 1.83' Iron Pipe - West 5.41'
Kent Co. Mon. (H-13, T10N, R11W) - East 187.47'

STATE OF MICHIGAN
KIRK BREITELS
LAND SURVEYOR
NO
30077
LICENSED LAND SURVEYOR

Signed by _____ Date 2/19/98

Surveyor's Michigan License No. 30077

FORM APPROVED BY MICHIGAN STATE BOARD OF PROFESSIONAL SURVEYORS, JAN. 28, 1971
REVISED MAY 14,1975
REVISED JAN., 1983
REVISED OCT., 1995