

MAR 08 1998

KENT COUNTY REMONUMENTATION

\$7.00
\$2.00

SECTION

LAND CORNER RECORDATION CERTIFICATE
Filing Requirement of Act 74, Mich. P.A. 1970

For corners in

KENT COUNTY
(County)

Located in:

Corner Code #

- 1. Public Land Survey T 9N R 11W H-9
- T R
- T R
- T R
- T R
- 2. Property Controlling in Section S T R
- S T R
- 3. Miscellaneous S T R
- Property in Sec. S T R

- 4. Lot No. _____, Recorded Plat _____
- 5. Private Claims _____

I, Kirk Breitels, in a field survey on Jan. 9, 1998, do hereby state that under requirements of P.A. 74, Michigan P.A. of 1970, the corner points mentioned in lines 1 and 2 above were in conformance with regulations and rules therefore as required in the current manual of survey instructions of the United States Department of the Interior, Bureau of Land Management or by a decree of a Court of Law and/or that the corner points mentioned in lines 3, 4 and 5 above were in conformance with the rules of the Michigan Board of Land Surveyors or by a Decree of a Court of Law; established, re-established, monumented, recovered, found as expressed below:

NOTE: Not more than 2 corners, all in the same town and range, may be recorded on this certificate.

A. Description of original monument and accessories and/or subsequent restoration:

- H-9 1837 GLO Whitcomb Set Post
- 1964 Kent Co. Wits Spike in bridge deck
- 1973 LCRC #534 Spicer PK Nail
- 1983 LCRC #3496 Stadt Cut "X" in bridge deck - Did not set Kent County Monument
- 1994 LCRC #7020 Byl Set PK & KC Remon. tag in bridge deck

The position of this corner was previously approved by the Kent County Remonumentation Peer Group, monumented (Cut "X" in bridge deck) by Russell E. Stadt on 7-28-83 and was recorded per LCRC #3496.

B. Description of corner evidence found and/or method applied in restoring or reestablishing corner:

H-9 Found PK Nail & KC Remon. tag per witnesses from above LCRC as set by William R. Byl at the same location as "X" as set by Russel E. Stadt in 1983. Said PK Nail & KC Remon. checks with LCRC #534. Kent Co. Wits. are gone.
LCRC #3496 LCRC #7020

- Top C/L guard post at NE cor. bridge - 41.02' Nail & Remon. tag top of guard rail post N70°E 41.09'
- Top C/L guard post at NW cor. bridge - 71.53' Nail & Remon. tag top of guard rail post N80°W 71.42'
- Top C/L guard post at SW cor. bridge - 71.25' Nail & Remon. tag top of guard rail post S80°W 71.12'
- Top C/L guard post at SE cor. bridge - 40.63' Nail & Remon. tag top of guard rail post S70°E 40.74'
- N. edge bridge - N. 17.3' S. edge bridge S. 16.4' Nail & Remon. tag MBT Pole N65°E 75.29'
- Nail & Remon. tag MBT Pole N65°E 75.29' N. edge bridge N. 17.29' S. edge bridge S. 16.39'

The selected location is accepted by me and is generally accepted by professional surveyors as the best available evidence of the position of the original corner.


C. Description of monument for corner and accessories established to perpetuate locating the position of the corner:

- H-9 PK Nail & KC Remon. tag
- Nail & KC Remon. tag Top of guard rail post N70°E 41.09'
- Nail & KC Remon. tag Top of guard rail post N80°W 71.42'
- Nail & KC Remon. tag Top of guard rail post S80°W 71.12'
- Nail & KC Remon. tag Top of guard rail post S70°E 40.74'
- Nail & KC Remon. tag S. side Tele. Pole N65°E 75.29'
- N. edge of bridge is N. 17.29' S. edge of bridge is S. 16.39'
- C/L expansion joint is W. 15.95'



Signed by Kirk Breitels
Surveyor's Michigan License No. 30077

Date 2/19/98

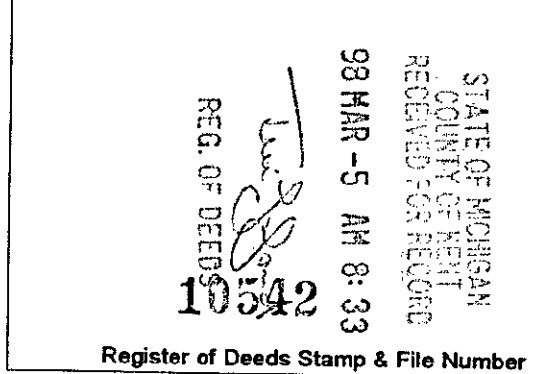

A	B	C	D	E	F	G	H	I	J	K	L	M
1												
2	6		5		4		3		2		1	
3												
4	7		8		9		10		11		12	
5												
6	18		17		16		15		14		13	
7												
8	19		20		21		22		23		24	
9												
10	30		29		28		27		26		25	
11												
12	31		32		33		34		35		36	
13												

P.A. 345 1990 KENT COUNTY
PEER APPROVED 2/19/98
CHAIRMAN Harry Huber